

Hearthstone Street
(66' Wide)

Sunflower Street
(66' Wide)

Plat of Survey


of

Lot 85 of Hearthstone of Elkhorn Addition No. 1,



located in the Northeast 1/4 of Section 25, Town 3 North, Range 16 East,
City of Elkhorn, Walworth County, Wisconsin.



Surveyed for: **Wayne Grau**
215 West Sunflower Street
Elkhorn, Wisconsin. 53121

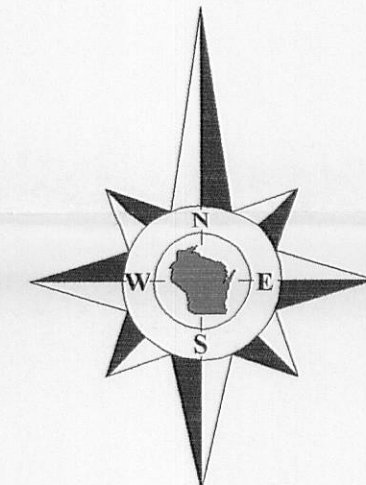

Bearings referenced to the plat of
Hearthstone of Elkhorn Addition No. 1.

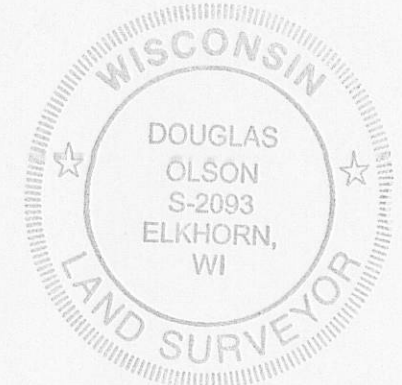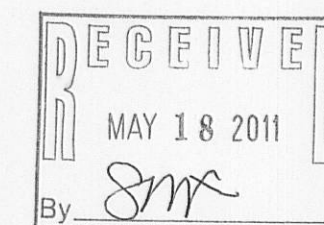

Copyright 2010 by Jensen & Olson Land Surveying, LLC.


All rights reserved. No part of this survey plat may be reproduced or transmitted in any form by any means - graphic, electronic, or mechanical, including photocopying, tracing, or information storage and retrieval systems - without permission in writing from Douglas G. Olson, Jensen & Olson Land Surveying, LLC.

I hereby certify that I have surveyed the above described property and the map hereon is correct to the best of my professional knowledge and belief and shows the size and location of the property, its exterior boundaries, the location and dimensions of all visible structures thereon, boundary fences, apparent easements and roadways and visible encroachments, if any.

This survey is made for the exclusive use of the present owners of the property, and also those who purchase, mortgage or guarantee title thereto, within one year from the date hereof.

Douglas G. Olson
Wisconsin Registered Land Surveyor - 2093

Survey Date: July 15, 2010.
Revisions:

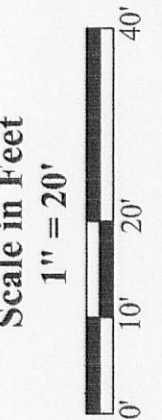

Jensen & Olson Land Surveying, LLC
45 South Wisconsin Street * P.O. Box 322 * Elkhorn, Wisconsin. 53121
Telephone: (262) 723-3434 * Facsimile: (262) 723-8044
Email: jensen.olson@elknet.net

Legend
Found Iron Pipe
Set Iron Rod, 3/4" dia.
Recorded Information

Sheet 1 of 1 Sheets
Drawing Name: G:\16-2010\065-2010\065Plat.srf
Job Reference Number
2010.065

2010.065