


DAVENDORF ST.

#182-68

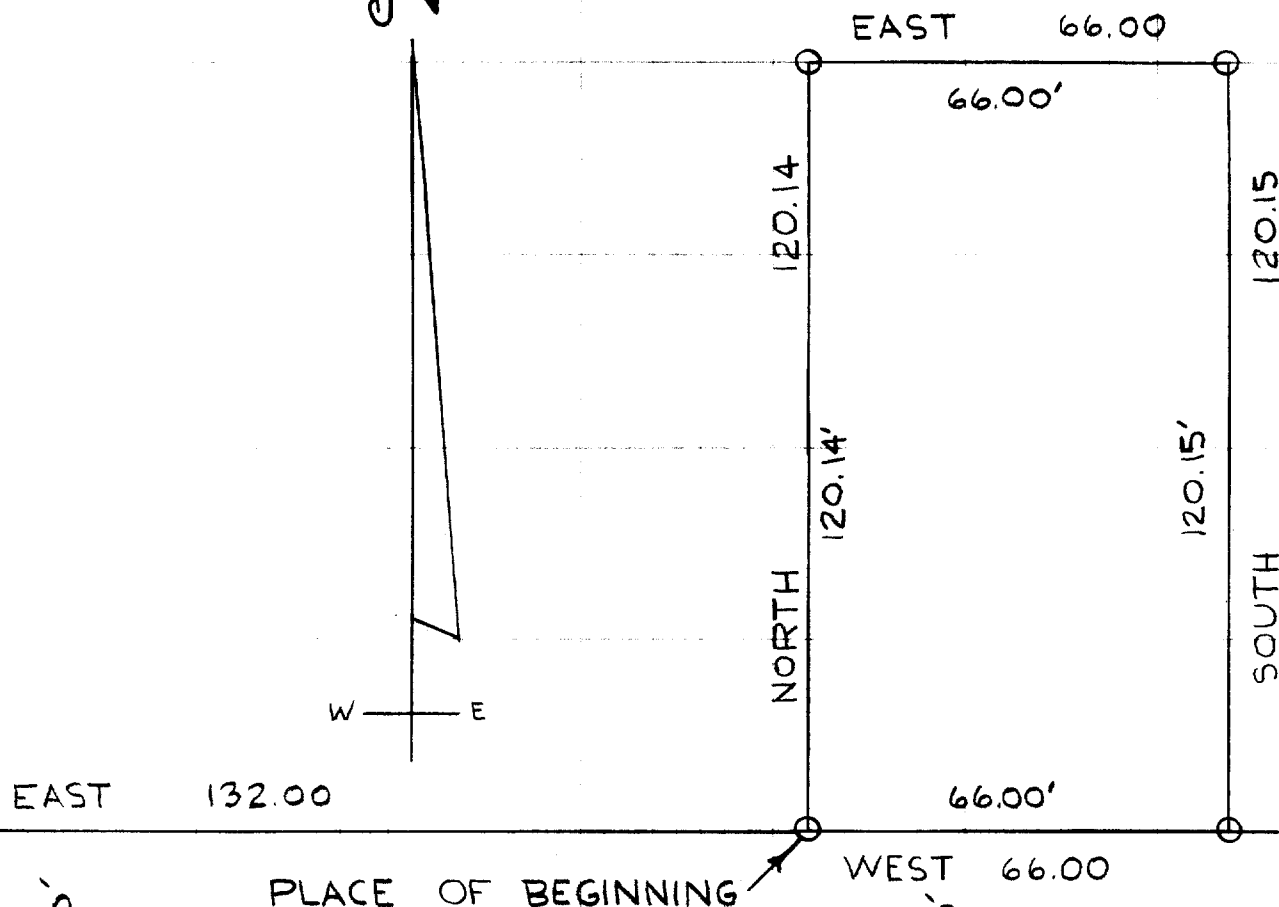

PLACE OF BEGINNING


W. GENEVA ST.

66.00' WIDE

DESCRIPTION: Commencing at a point in the North line of W. Geneva Street that is 132.00 feet East of intersection of said North line and the East line of Davendorf Street in the city of Elkhorn, Walworth County, Wisconsin, thence North 120.14 feet, thence East 66.00 feet, thence South 120.15 feet, thence West 66.00 feet to the place of beginning.

CERTIFICATE: I, James F. Biagi, surveyor, do hereby certify that I have surveyed the property hereon described.

December 17, 1968.

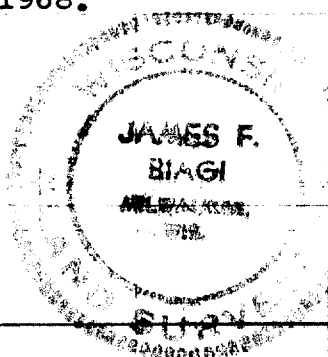

James F. Biagi
James F. Biagi RLS 1272

U-NW-225

4-231B