PREPARED FOR: MOISES PEREZ 128 EASTOWN MANOR ELKHORN WI 53121

PLAT OF SURVEY

:01:


UNIT 128, EASTOWN MANOR CONDOMINIUM, LOCATED IN THE CITY OF ELKHORN, WALWORTH COUNTY, WISCONSIN.

KROTT SUR VEYING INC.


N3705 WILLOW BEND LANE
LAKE GENEVA WI. 53147

PHONE # (262)248-3697
FAX # (262)249-0639

30' WIDE STREET COMMON AREA

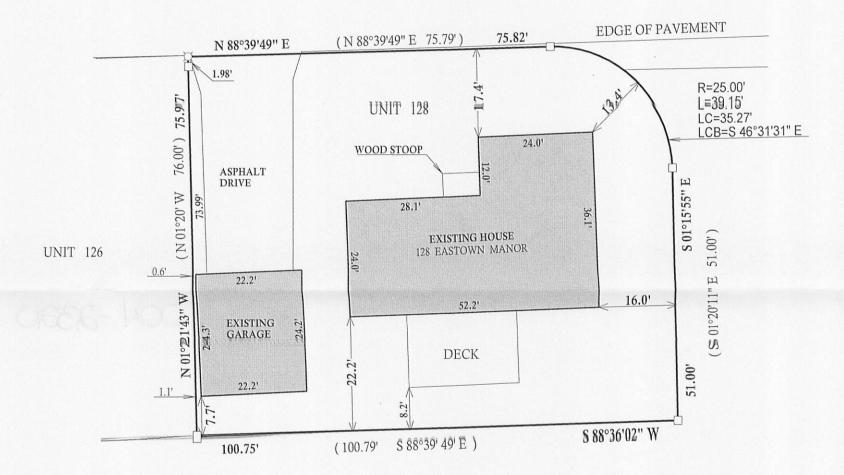

COMMON AREA RECREATION AREA

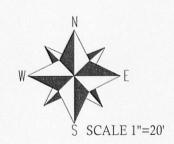

BEARINGS REFERENCED TO THE RECORD PLAT OF EASTOWN MANOR

LEGEND

- ☐ FOUND NAIL
- O FOUND IRON PIPE
- ☐ FOUND IRON BAR
- SET IRON BAR

(XX) RECORDED AS

JOB # 11-081





I have surveyed the above-described property and the above map is a true representation thereof and shows the size and location of the property, its exterior boundaries, the location and dimensions of all structures thereon, fences apparent easements and roadways and visible encroachments. if any.

This survey is made for the exclusive use of the present owners of the property, and also those who puchase, mortgage, or insure the title therto within one (1) year from date hereof; and as to them I warrant the accuracy of said survey map.



DATED THIS 27th, DAY OF MAY, 2011

JOHN KROTT S - 2258 Wisconsin Registered Land Surveyor (original if signed in red)

