


PLAT OF SURVEY


-OF-

LOT 80, ELKHORN WEST ADDITION NO. 1, BEING PART OF THE NORTHEAST 1/4 AND THE SOUTHEAST 1/4 OF THE SOUTHEAST 1/4 OF SECTION 35, TOWNSHIP 3 NORTH, RANGE 16 EAST, AND PART OF THE NORTHEAST 1/4 OF THE NORTHEAST 1/4 OF SECTION 2, TOWNSHIP 2 NORTH, RANGE 16 EAST, CITY OF ELKHORN, WALWORTH COUNTY, WISCONSIN.

SURVEY FOR: HOMESTEAD REALTY OF LAKE GENEVA
 SURVEY ADDRESS: 1146 W. COURT STREET

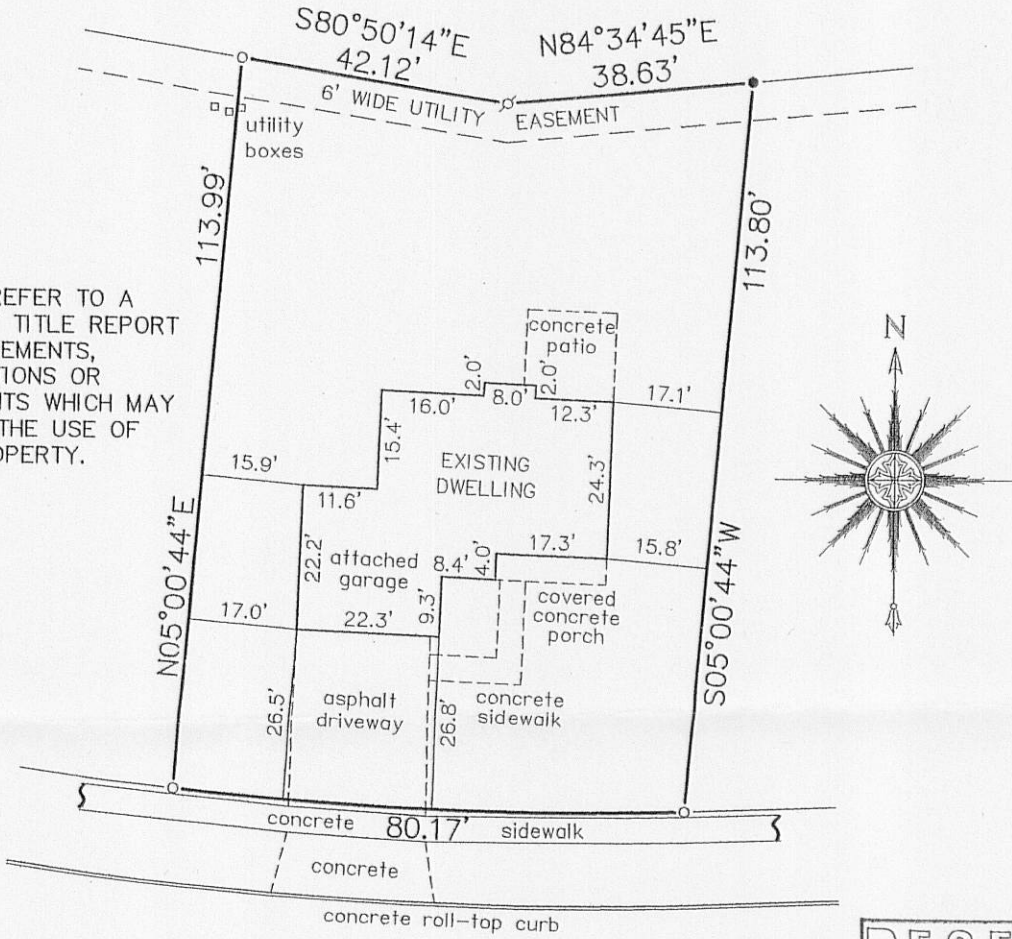

NOTE: REFER TO A CURRENT TITLE REPORT FOR EASEMENTS, RESTRICTIONS OR COVENANTS WHICH MAY AFFECT THE USE OF THIS PROPERTY.

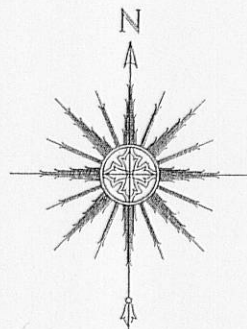


W. 66' WIDE COURT ST.

LEGEND



- FOUND IRON PIPE
- ⊕ FOUND IRON ROD
- SET IRON PIPE

CURVE DATA

RADIUS = 600.00'
 DELTA = 07°39'19"
 CHORD = 80.11'
 C.B. = N87°56'44.5"W

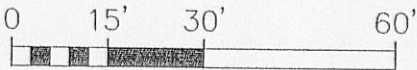

SCALE: 1" = 30'

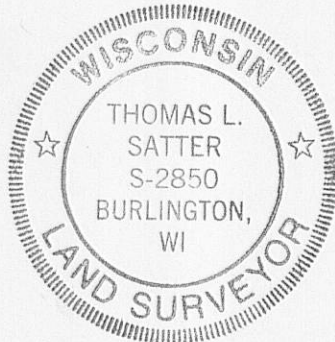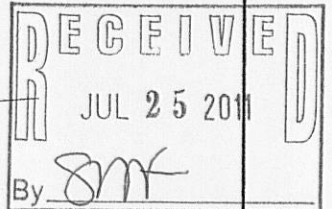

THIS IS NOT AN ORIGINAL PRINT
 UNLESS THIS SEAL IS RED.

Thomas L. Satter
 THOMAS L. SATTER S-2850

SATTER SURVEYING, LLC
 LAND SURVEYS, MAPPING AND PLANNING
 272 ORIGEN STREET
 BURLINGTON, WI 53105
 262-661-4239

JULY 19, 2011 DATE
 071101 JOB NUMBER

YEW1-80

004-2322

004-2322