

PREPARED FOR
 JOHN LAW
 RE/MAX GENEVA REALTY LTD
 101 BROAD ST.
 SUITE 102
 LAKE GENEVA WI. 53147.

PLAT OF SURVEY



KROTT SURVEYING INC.

N3705 WILLOW BEND LANE
 LAKE GENEVA WI. 53147
 PHONE # (262)248-3697
 FAX # (262)249-0639

-OF-
 LOT 39, JACKSON CREEK EAST SUBDIVISION, LOCATED IN
 THE SOUTHWEST AND SOUTHEAST 1/4'S OF THE SOUTH-
 WEST 1/4 OF SECTION 7, TOWN 2 NORTH, RANGE 17 EAST,
 CITY OF ELKHORN, WALWORTH COUNTY, WISCONSIN.

C.L. GRANT STREET

(66' WIDE)

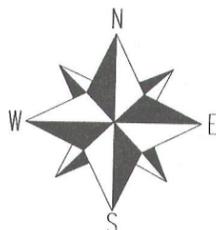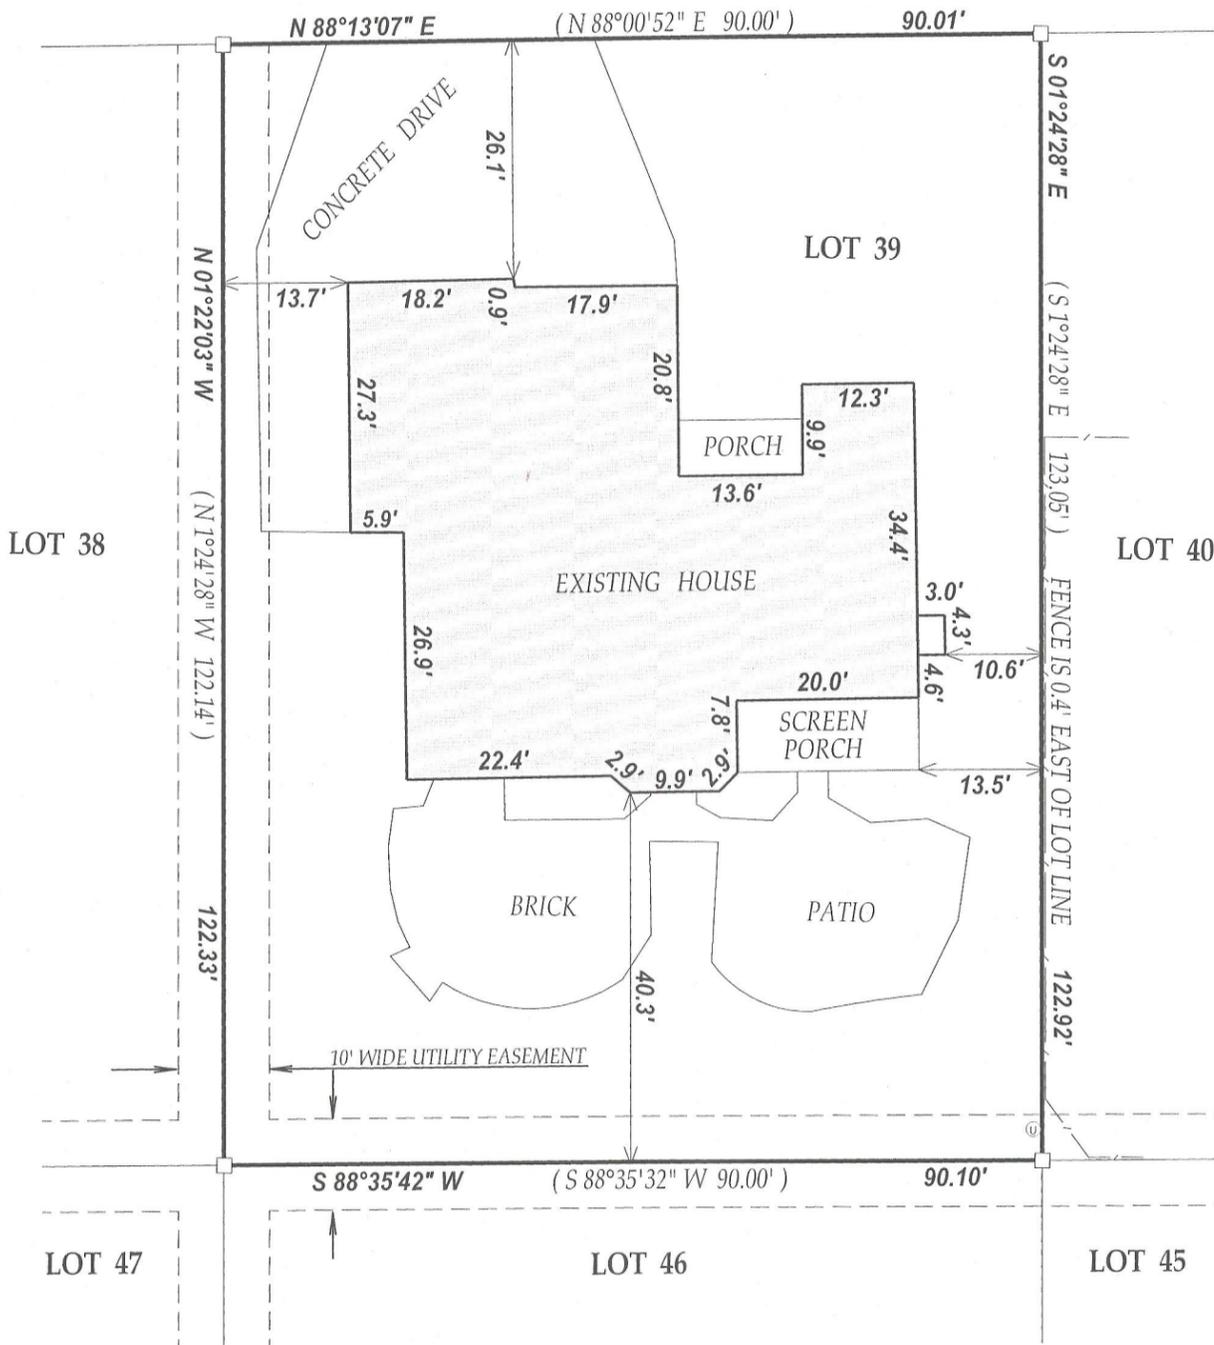

SCALE 1" = 20'



NOTE: BEARINGS ARE REFERENCED TO THE RECORD PLAT



DATED THIS 2nd DAY OF APRIL 2012.

[Signature]

JOHN KROTT S - 2258
 Wisconsin Registered Land Surveyor
 (original if signed in red)

LEGEND

- FOUND IRON BAR
- ⊙ UTILITY PEDESTALS

(xx) RECORDED AS

TAX ID # YJCE00039

JOB # 12-034

This survey is made for the exclusive use of the present owners of the property, and also those who purchase, mortgage, or insure the title thereto within one (1) year from date hereof; and as to them I warrant the accuracy of said survey map.

004-2347