LOT

SOUTH LINE

ASSIGNED

88°35'32"

S


PLAT OF SURVEY

LOT 40 OF JACKSON CREEK EAST SUBDIVISION LOCATED IN THE SW & SE 1/4'S OF THE SW 1/4 SEC. 7 TOWN 2 NORTH, RANGE 17 EAST CITY OF ELKHORN, WALWORTH COUNTY, WI.

- WORK ORDERED BY -ROBERT SPUHLER 403 GRANT STREET ELKHORN, WI. 53121

GRANT STREET

66' WIDE PUBLIC ROW

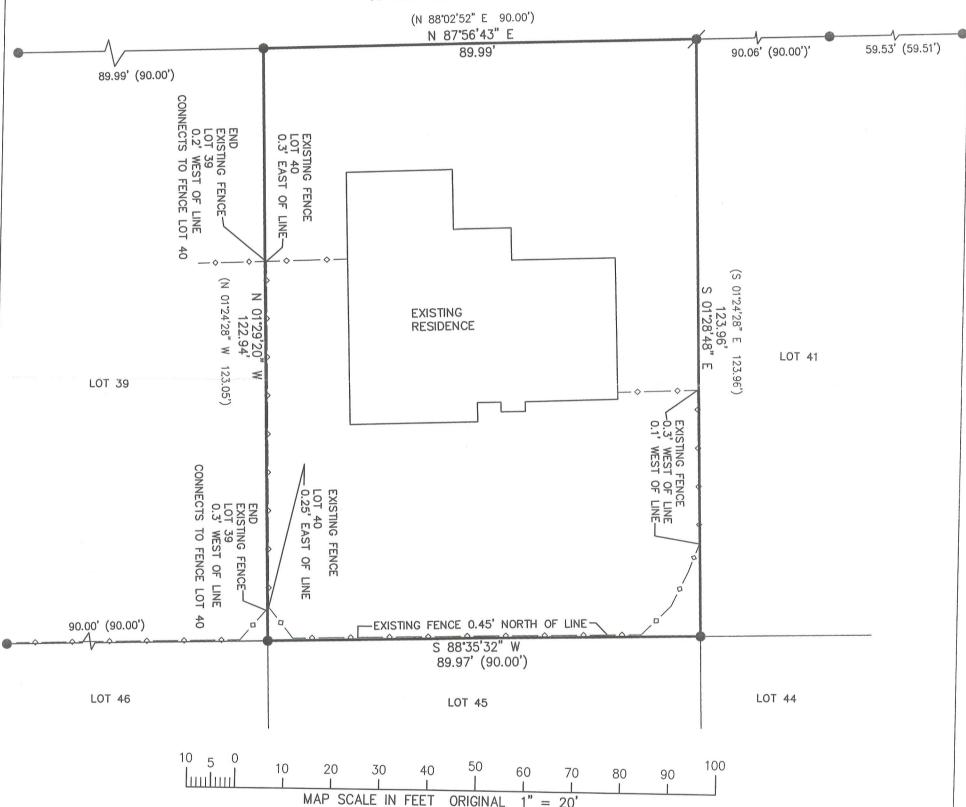

NOTE: COPIES OF THIS MAP TO WHICH THE FOLLOWING CERTIFICATE WILL APPLY SHOW THE SURVEYOR'S ORIGINAL SEAL AND SIGNATURE IN RED INK. COPIES BY ANY OTHER MEANS MAY HAVE ALTERATIONS WHICH DO NOT REPRESENT THE SURVEYOR'S WORK PRODUCT.

I HEREBY CERTIFY THAT THE ABOVE DESCRIBED PROPERTY HAS BEEN SURVEYED UNDER MY DIRECTION AND THAT THE ABOVE MAP IS A TRUE REPRESENTATION THEREOF AND SHOWS THE SIZE AND LOCATION OF THE PROPERTY AND ITS EXTERIOR BOUNDARIES. THIS SURVEY IS MADE FOR THE USE OF THE PRESENT OWNERS OF THE PROPERTY, AND ALSO THOSE WHO PURCHASE, MORTGAGE, OR GUARANTEE THE TITLE THERETO WITHIN ONE YEAR FROM THE DATE HEREOF.

DATED: MAY 3, 2012


PETER S. GORDON R.L.S. 2101



= FOUND IRON REBAR STAKE

= FOUND IRON REBAR STAKE

(XXX) = RECORDED AS

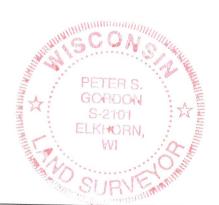



PROJECT: 4055.40 DATE: 05-03-2012

SHEET 1 OF 1