


045-4

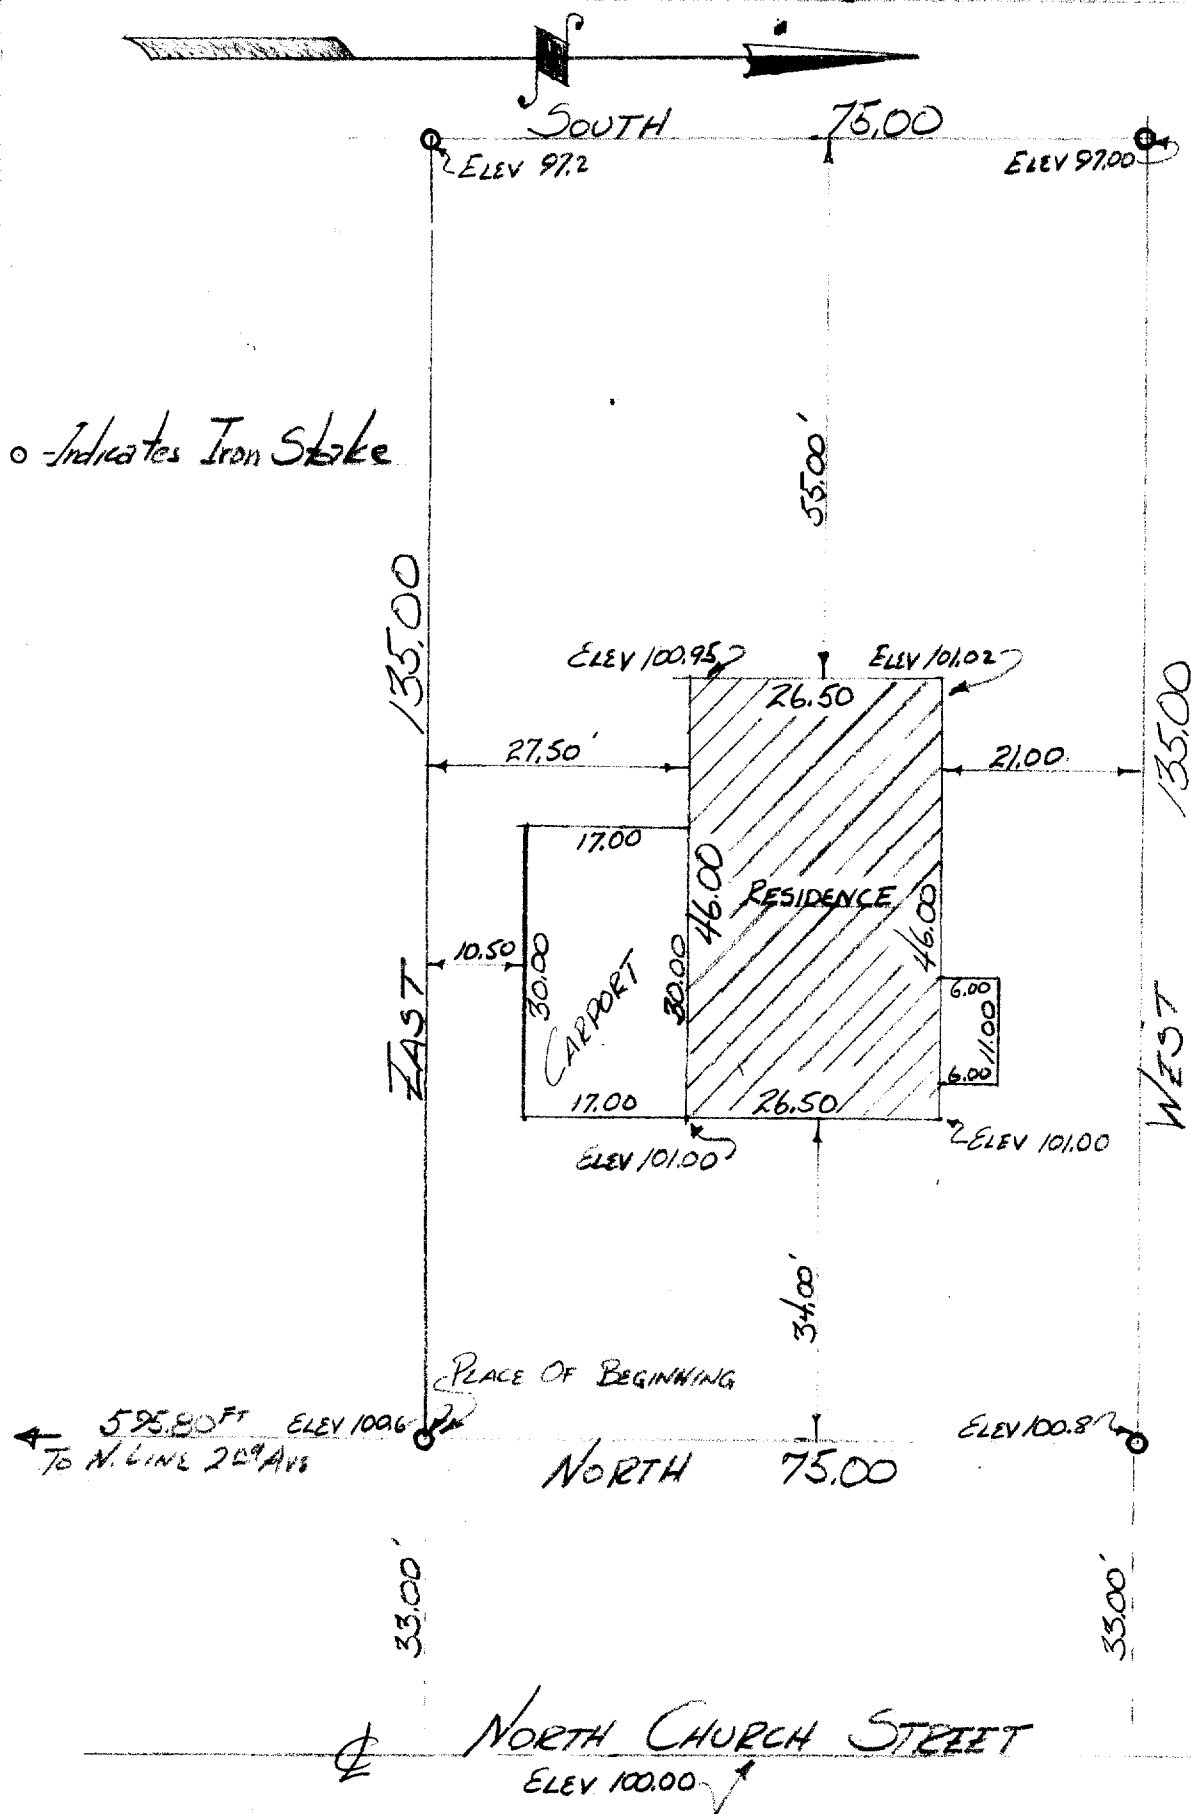

DESCRIPTION: Commencing at an iron stake in the West line of North Church Street in the City of Elkhorn, that is 595.80 feet North of the intersection of the North line of Second Avenue with the West line of North Church Street, in said city, thence North 75.00 feet to an iron stake, thence West 135.00 feet to an iron stake, thence South 75.00 feet to an iron stake, thence East 135.00 feet to the place of beginning.

CERTIFICATE: I hereby certify that I have on this 22nd day of October, 1958 surveyed the above described property, and the residence is located on the property as shown on the sketch, I further certify that the measurements and bearings of the boundary lines are in accordance with those shown above.

SIGNED AND SEALED ON THE 23RD DAY OF OCTOBER 1958

Surveyor No. 272

U-NW-35

NE 4 - 36-3-16

4-240

045-4