FARRIS, HANSEN & ASSOCIATES, INC.

ENGINEERING - ARCHITECTURE - SURVEYING 7 RIDGWAY COURT - P.O. BOX 437 - ELKHORN, WISCONSIN PHONE: (262) 723-2098 FAX: (262) 723-5886

PLAT OF SURVEY


LOT 168 OF ELKHORN WEST ADDITION NO. 2

- WORK ORDERED BY -

5803 GLEN HAVEN DRIVE GREENDALE, WI. 53129

LOCATED IN PART OF THE NE 1/4 OF THE SE 1/4 OF SECTION 35 TOWN 3 NORTH, RANGE 16 EAST, CITY OF ELKHORN, WALWORTH COUNTY, WISCONSIN

> ROSEMARY ROAD 66' MDE R.O.W.

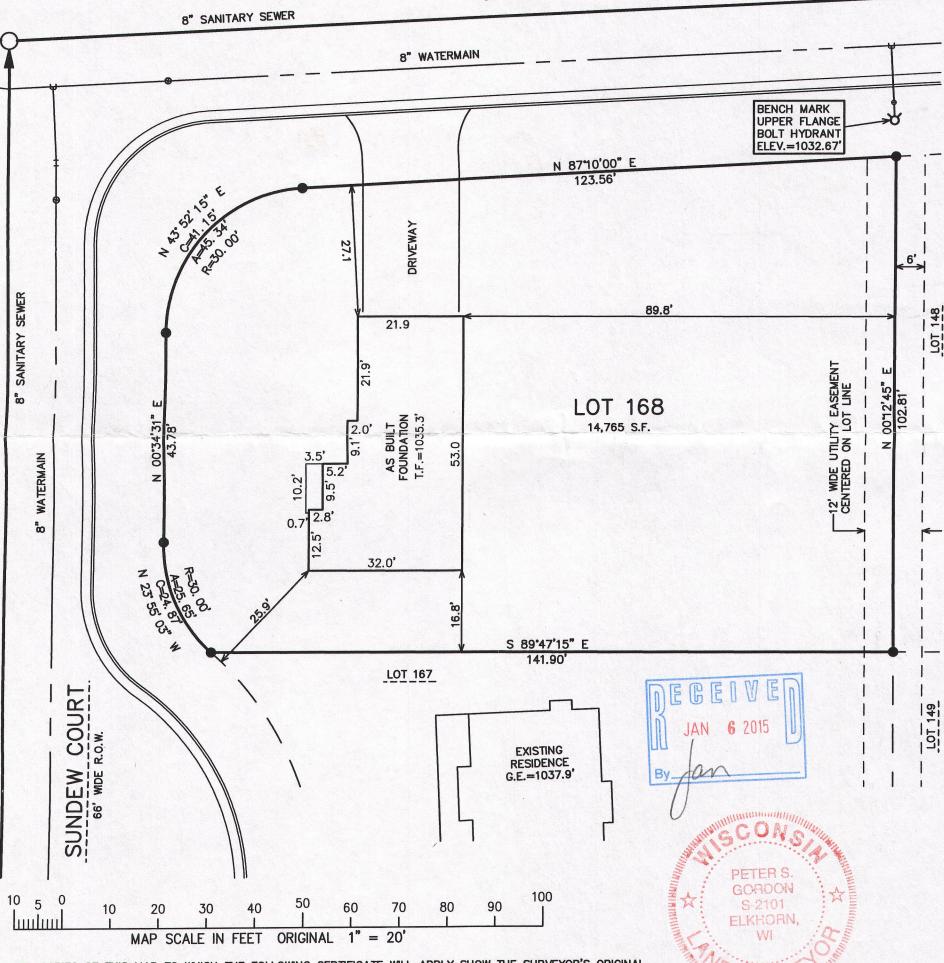

NOTE: COPIES OF THIS MAP TO WHICH THE FOLLOWING CERTIFICATE WILL APPLY SHOW THE SURVEYOR'S ORIGINAL SEAL AND SIGNATURE IN RED INK. COPIES BY ANY OTHER MEANS MAY HAVE ALTERATIONS WHICH DO NOT REPRESENT THE SURVEYOR'S WORK PRODUCT.

HEREBY CERTIFY THAT THE ABOVE DESCRIBED PROPERTY HAS BEEN SURVEYED UNDER MY DIRECTION AND THAT THE ABOVE MAP IS A TRUE REPRESENTATION THEREOF AND SHOWS THE SIZE AND LOCATION OF THE PROPERTY AND ITS EXTERIOR BOUNDARIES. THIS SURVEY IS MADE FOR THE USE OF THE PRESENT OWNERS OF THE PROPERTY, AND ALSO THOSE WHO PURCHASE, MORTGAGE, OR GUARANTEE THE TITLE THERETO WITHIN ONE YEAR FROM THE DATE

DATED: SEPTEMBER 19, 2005

REVISED 9/12/2014-KB
TO SHOW SIZE & LOCATION
OF PROPOSED RESIDENCE

REVISED 10/31/2014-KB TO ADD TOPOGRAPHICAL **INFORMATION**

TO SHOW SIZE & LOCATION OF

PROJECT: 6103.02.168 DATE: 09/19/2005 SHEET 1 OF 1

LEGEND

(XXX) = RECORDED AS

= SET IRON REBAR STAKE

= FOUND IRON PIPE STAKE

PETER S. GORDON R.L.S. 2101

REVISED 12-08-2014 AS BUILT FOUNDATION

DEC 08 2014

_2_INDV_LOTS\Lot_168\Lot_168RE

X: \Projects\6103\

12/8/2014

004-2442 YEW2-168