PREPARED FOR: LAKE GENEVA AREA REALTY 101 BROAD ST LAKE GENEVA, WI.


PLAT OF SURVEY


- OF -

LOT 54 OF JACKSON CREEK EAST SUBDIVISION, LOCATED IN THE SW AND SE 1/4'S OF THE SW 1/4 OF SECTION 7, TOWN 2 NORTH, RANGE 17 EAST, CITY OF ELKHORN, WALWORTH COUNTY, WISCONSIN.

PATHFINDER SURVEYING INC. (formerly) J.K. SURVEYING INC. P.O BOX 322 LAKE GENEVA, WI. 53147 WWW.PATHFINDERSURVEYING.NET 262-248-8303

SOUTH CREEK DRIVE

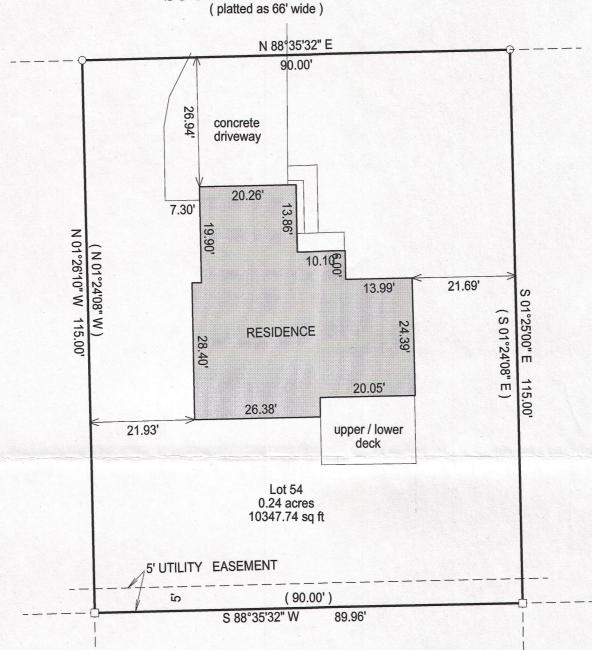

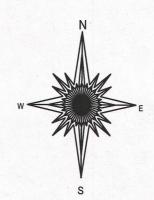

()= recorded as

 \Box = found iron bar

= found iron pipe

= set iron pipe

= set iron bar

SCALE 1" = 20'

JOB # 14-226


TAX ID # YJCE00054

0 20 40
BASIS OF BEARING OF THIS PLAT: THE SOUTH LINE
OF SOUTH CREEK DRIVE WA ASSUMED TO BEAR 20 N88°35'32" E AS SHOWN ON THE RECORD PLAT.

I hereby certify that I have surveyed the above- described property and the above map is a is a true representation thereof and shows the size and location of the property, its exterior boundaries, the location and dimensions of all structures thereon, fences, apparant easements and roadways and visible encroachments if any.

This survey is made for the present owners of the property, and those who purchase, mortgage, or guarantee the title thereto, within one year from

DATED THIS 25TH DAY OF SEPTEMBER, 2014.

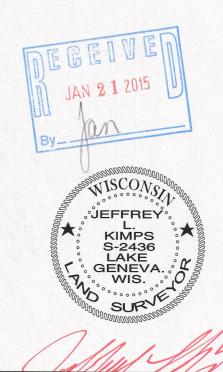

JEFREY L KIMPS 8-2436 Wisconsin Registered Land Surveyor (original if signed in red)