PREPARED FOR TOM KNAPP

PLAT OF SURVEY

- OF -

PATHFINDER SURVEYING INC.

(formerly)


J.K. SURVEYING INC.

P.O BOX 322

LAKE GENEVA, WI. 53147

WWW.PATHFINDERSURVEYING.NET
262-248-8303

LOT 1 BLOCK 6, OF THE ORIGINAL PLAT OF THE VILLAGE (NOW CITY) OF ELKHORN, WALWORTH COUNTY, WISCONSIN.

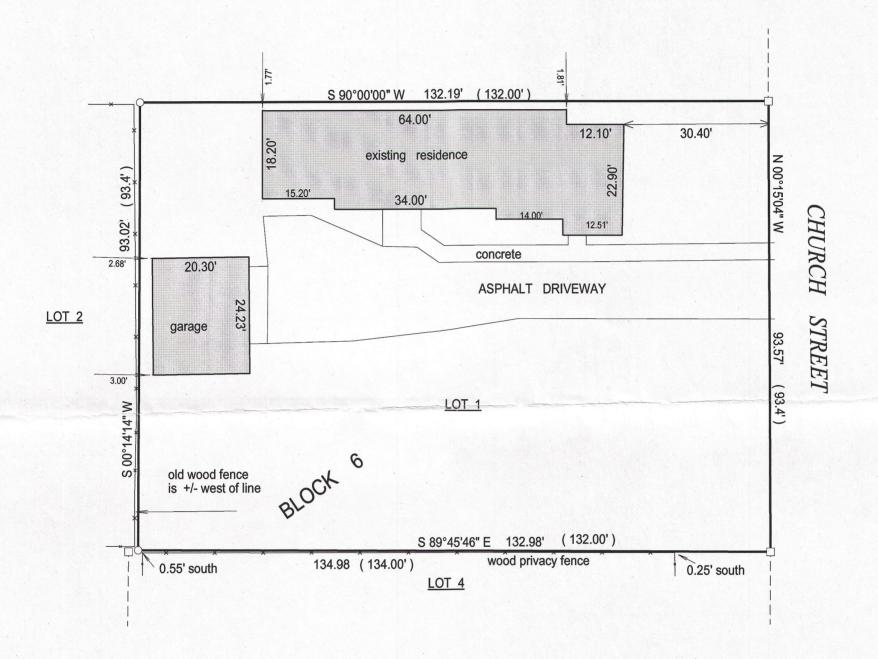

()= recorded as

□ = found iron bar

= found iron pipe


= set iron pipe

= set iron bar

SCALE 1" = 20'

JOB # ₁₄₋₂₄₄

TAX ID # YOP00016

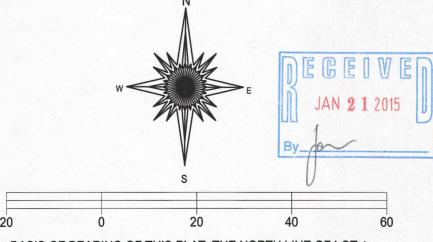

BASIS OF BEARING OF THIS PLAT: THE NORTH LINE OF LOT 1 BLOCK 6 WAS ASSUMED TO BEAR WEST.

I hereby certify that I have surveyed the above- described property and the above map is a is a true representation thereof and shows the size and location of the property, its exterior boundaries, the location and dimensions of all structures thereon, fences, apparant easements and roadways and visible encroachments if any.

This survey is made for the present owners of the property, and those who purchase, mortgage, or guarantee the title thereto, within one year from the date hereof.

DATED THIS 9th day of October, 2014.



JEFFREY L KIMPS S - 2436 Wisconsin Registered Land Surveyor (original if signed in red)