
PLAT OF SURVEY -OF-

LOT 6 OF "WESTWARD POINTE", A SUBDIVISION RECORDED IN CABINET C OF PLATS, SLIDE 177 AS DOCUMENT NO. 593775, IN THE CITY OF ELKHORN, WALWORTH COUNTY, WISCONSIN.

SURVEY FOR: HOMESTEAD REALTY INC.

SURVEY ADDRESS: 211 W. WESTWARD DRIVE, ELKHORN, WI 53121

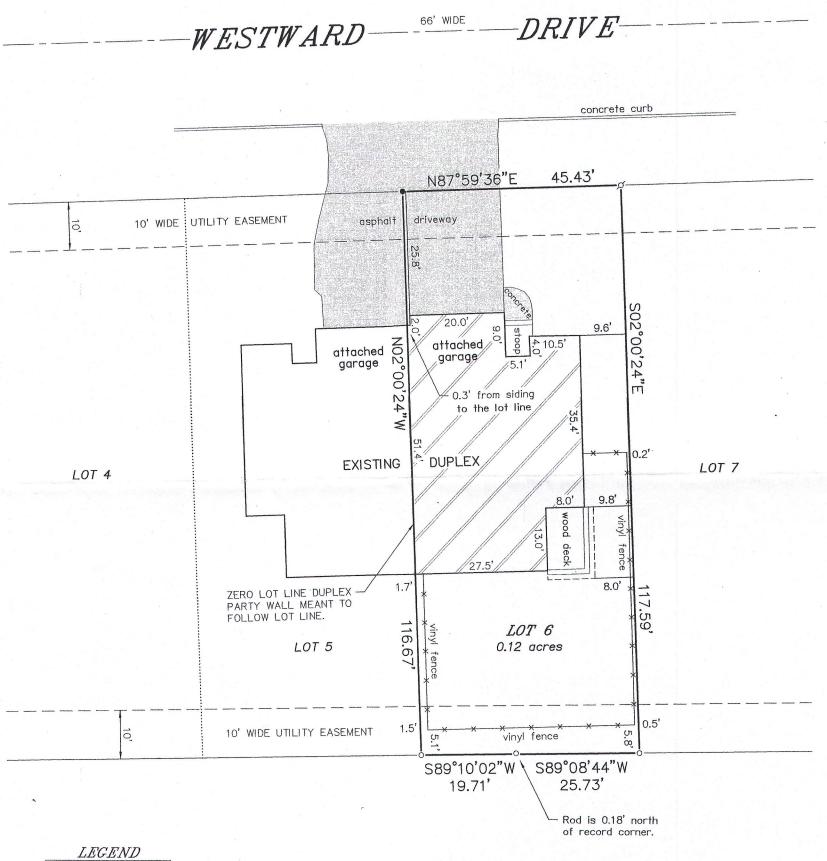

- 0 FOUND IRON ROD
- FOUND MASONRY NAIL
- SET IRON PIPE


"I HEREBY CERTIFY THAT I HAVE SURVEYED THE ABOVE THEREBY CERTIFY THAT I HAVE SURVEYED THE ABOVE DESCRIBED PROPERTY AND THAT THE ABOVE MAP IS A CORRECT REPRESENTATION THEREOF AND SHOWS THE SIZE AND LOCATION OF THE PROPERTY, ITS EXTERIOR BOUNDARIES, THE LOCATION OF ALL VISIBLE STRUCTURES AND DIMENSIONS OF ALL PRINCIPAL BUILDINGS THEREON, BOUNDARY FENCES, APPARENT EASEMENTS, ROADWAYS AND ENCROACHMENTS, IF ANY."


"THIS SURVEY IS MADE FOR THE USE OF THE PRESENT OWNERS OF THE PROPERTY, AND THOSE WHO PURCHASE, MORTGAGE, OR GUARANTEE THE TITLE THERETO WITHIN ONE YEAR FROM DATE HEREOF."

SATTER SURVEYING, LLC

LAND SURVEYS, MAPPING AND PLANNING

272 ORIGEN STREET BURLINGTON, WI 53105 262-661-4239

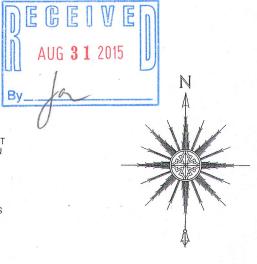

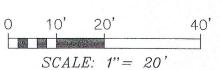



THIS IS NOT AN ORIGINAL PRINT UNLESS THIS SEAL IS RED.

S-2850

AUGUST 18, 2015 DATE

081506 JOB NUMBER