


PREPARED FOR  
BILL LEITH

# PLAT OF SURVEY

- OF -

PATHFINDER SURVEYING INC.  
(formerly)  
J.K. SURVEYING INC.  
P.O BOX 322  
LAKE GENEVA, WI. 53147  
WWW.PATHFINDERSURVEYING.NET  
262-248-8303

LOT 7, BLOCK 1 RIDGEWAY AND MARTIN'S ADDITION TO  
THE CITY OF ELKHORN, LOCATED IN SECTION 36, TOWN  
3 NORTH, RANGE 16 EAST, CITY OF ELKHORN, COUNTY  
OF WALWORTH AND STATE OF WISCONSIN.

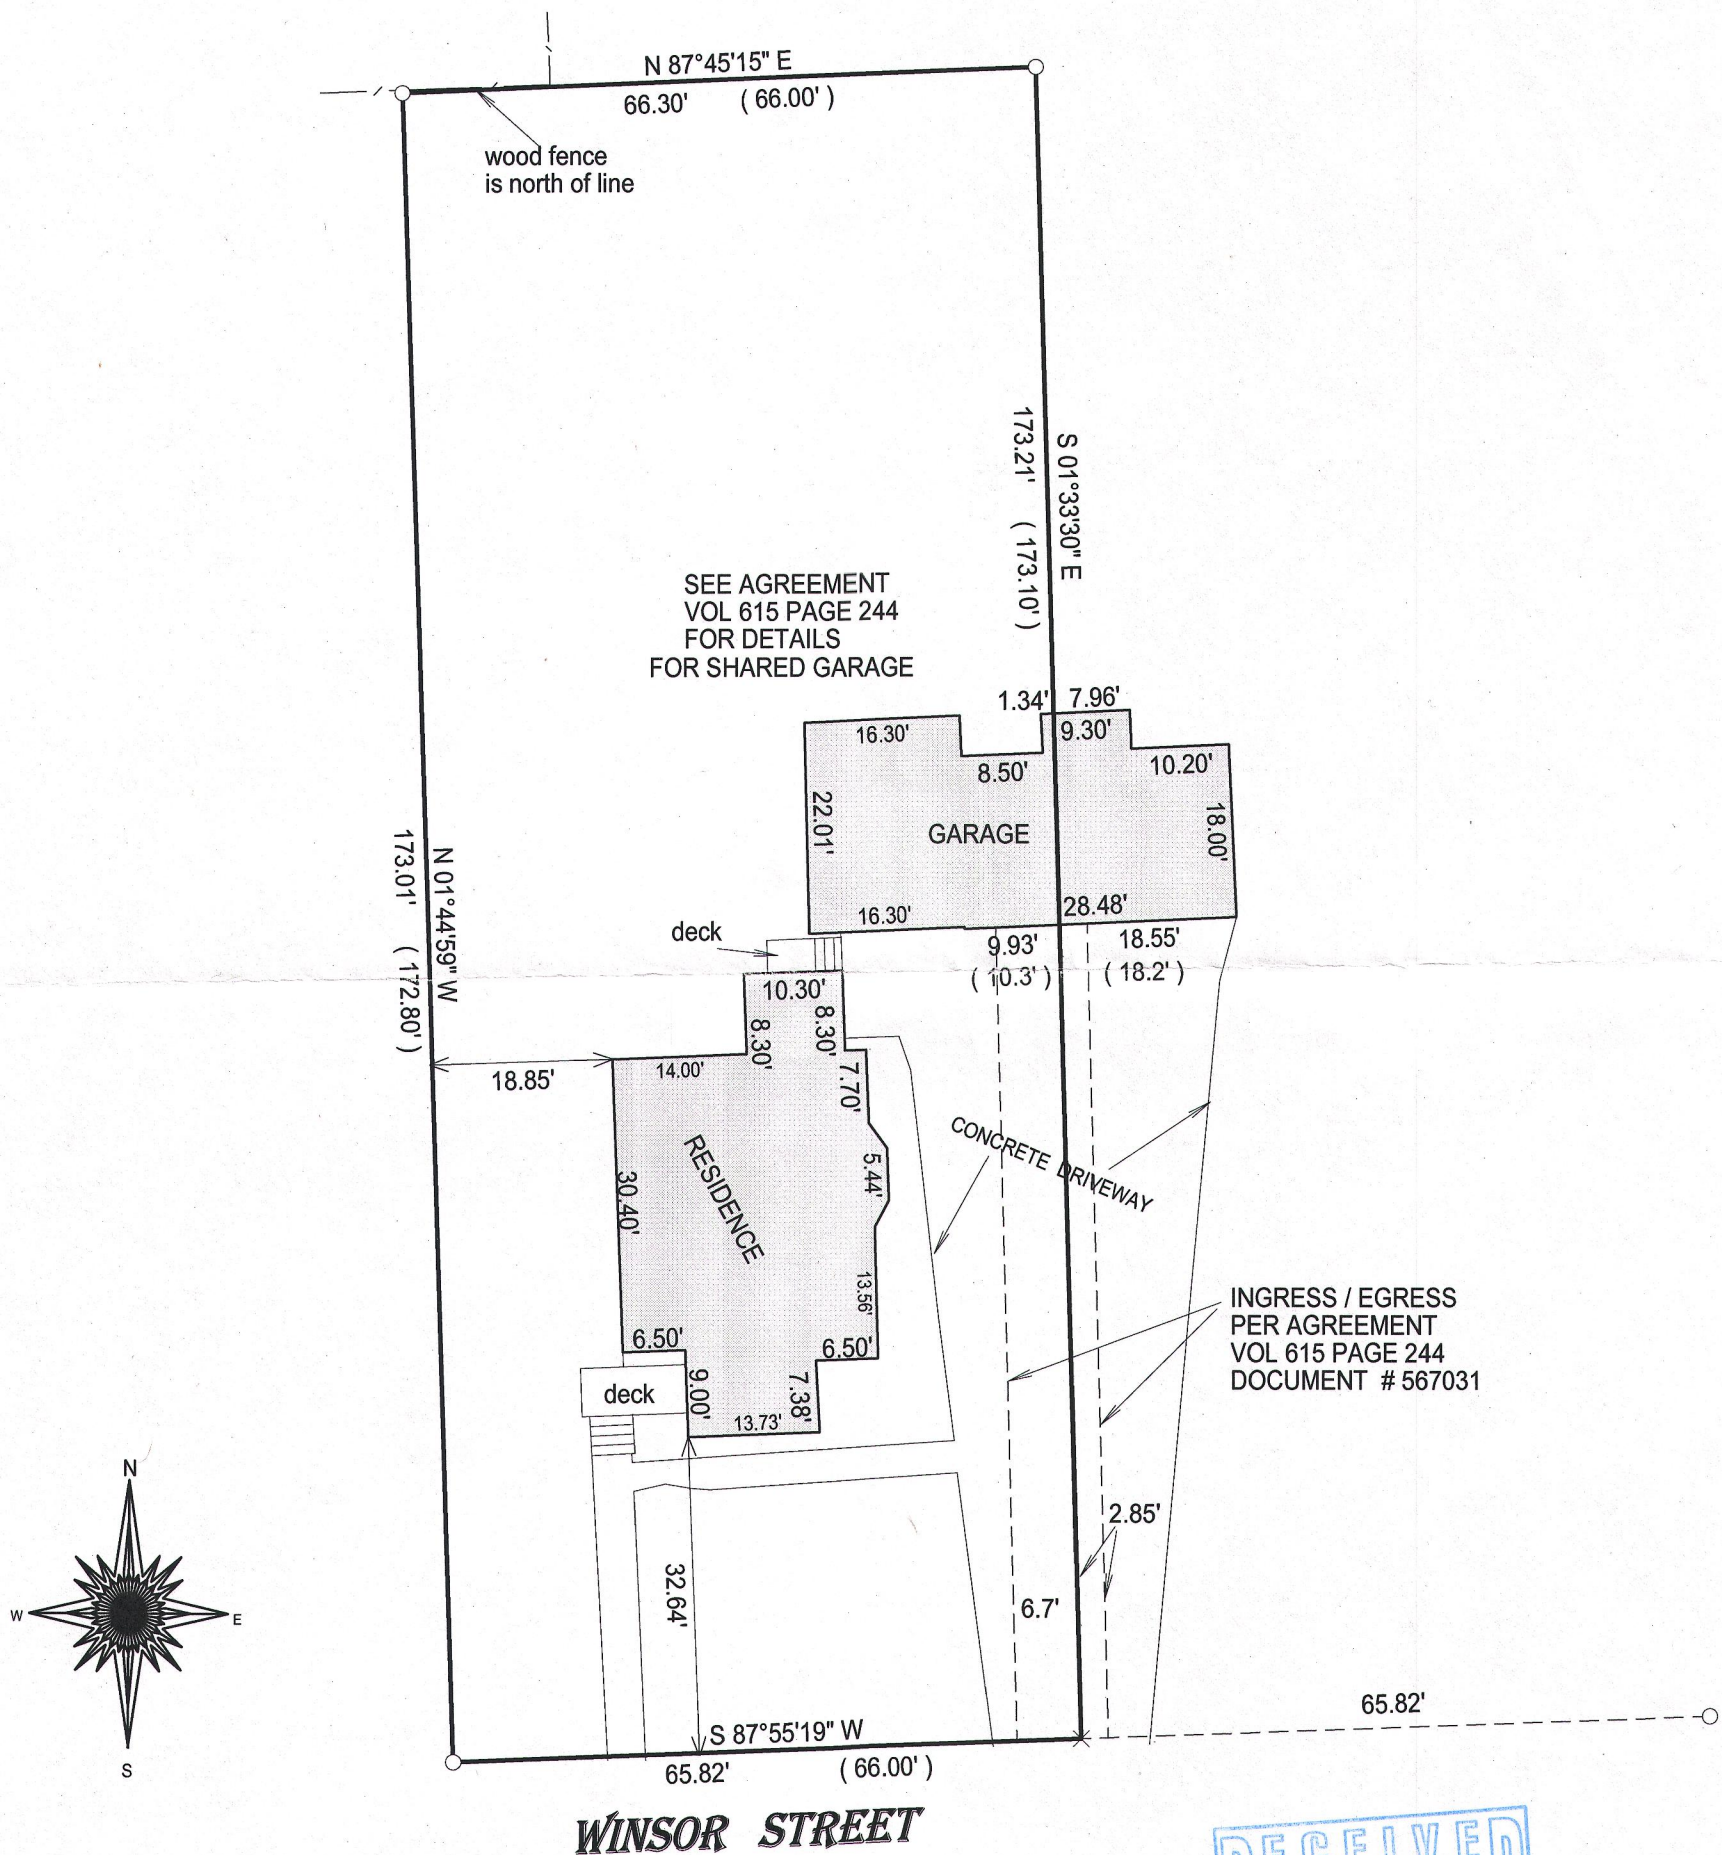


- ( ) = recorded as
- = found iron bar
- = found iron pipe
- = set iron pipe
- = set iron bar

SCALE 1" = 20'

JOB # 15-368

TAX ID # YRW 00007


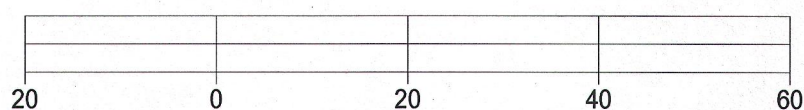


BASIS OF BEARING OF THIS PLAT: THE U.S. STATE PLANE COORDINATE  
SYSTEM, SOUTH ZONE, GRID NORTH, NAD 83. WISCORS.

I hereby certify that I have surveyed the above- described property and the  
above map is a true representation thereof and shows the size and  
location of the property, its exterior boundaries, the location and  
dimensions of all structures thereon, fences, apparrant easements and  
roadways and visible encroachments if any.

This survey is made for the present owners of the property, and those who  
purchase, mortgage, or guarantee the title thereto, within one year from  
the date hereof.

DATED THIS 25TH DAY OF NOVEMBER, 2015.

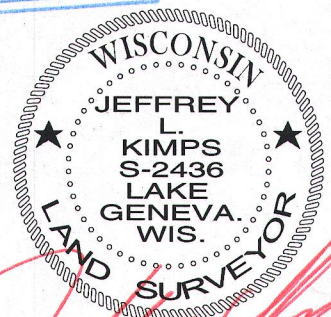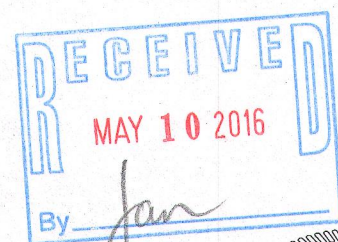

JEFFREY L KIMPS S-2436  
Wisconsin Professional Land Surveyor  
(original if signed in red)