


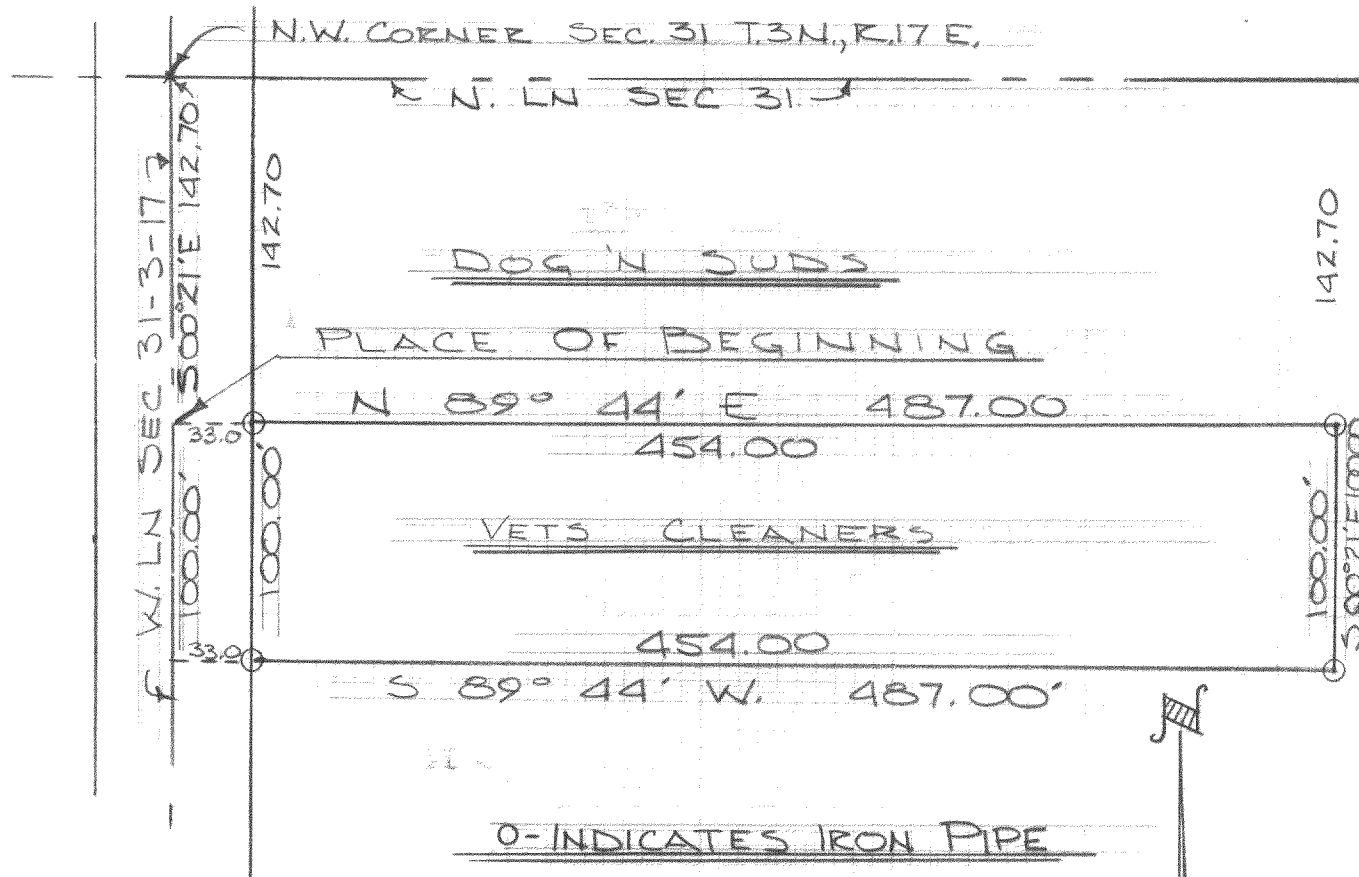

DESCRIPTION: Commencing at the NW corner of Section 31, T. 3 N., R. 17 E., in the City of Elkhorn, Walworth County, Wisconsin; thence S. 00° 21' E. 142.70 feet to the place of beginning of the lands hereinafter, described, to wit: thence N. 89° 44' E. 487.00 feet to an iron pipe, thence S. 00° 21' E. 100.00 feet to an iron pipe, thence S. 89° 44' W. 487.00 feet to the West line of Section 31, thence N. 00° 21' W. along the West Section line 100.00 feet to the place of beginning.

CERTIFICATE: I, James F. Biagi, surveyor, do hereby certify that I have surveyed the property hereon described.

Described September 23rd, 1969.
Surveyed December 1, 1969.

James F. Biagi, R.E. 54272

