FARRIS, HANSEN & ASSOCIATES, INC.


ENGINEERING - ARCHITECTURE - SURVEYING 7 RIDGWAY COURT - P.O. BOX 437 - ELKHORN, WISCONSIN 53121 PHONE: (262) 723-2098 FAX: (262) 723-5886

PLAT OF SURVEY

LOT 113 OF ELKHORN WEST ADDITION NO. 2

 WORK ORDERED BY -DAN CARMODY 5803 GLEN HAVEN DRIVE GREENDALE, WI. 53129

LOCATED IN PART OF THE NE 1/4 OF THE SE 1/4 OF SECTION 35
TOWN 3 NORTH, RANGE 16 EAST, CITY OF ELKHORN, WALWORTH COUNTY, WISCONSIN

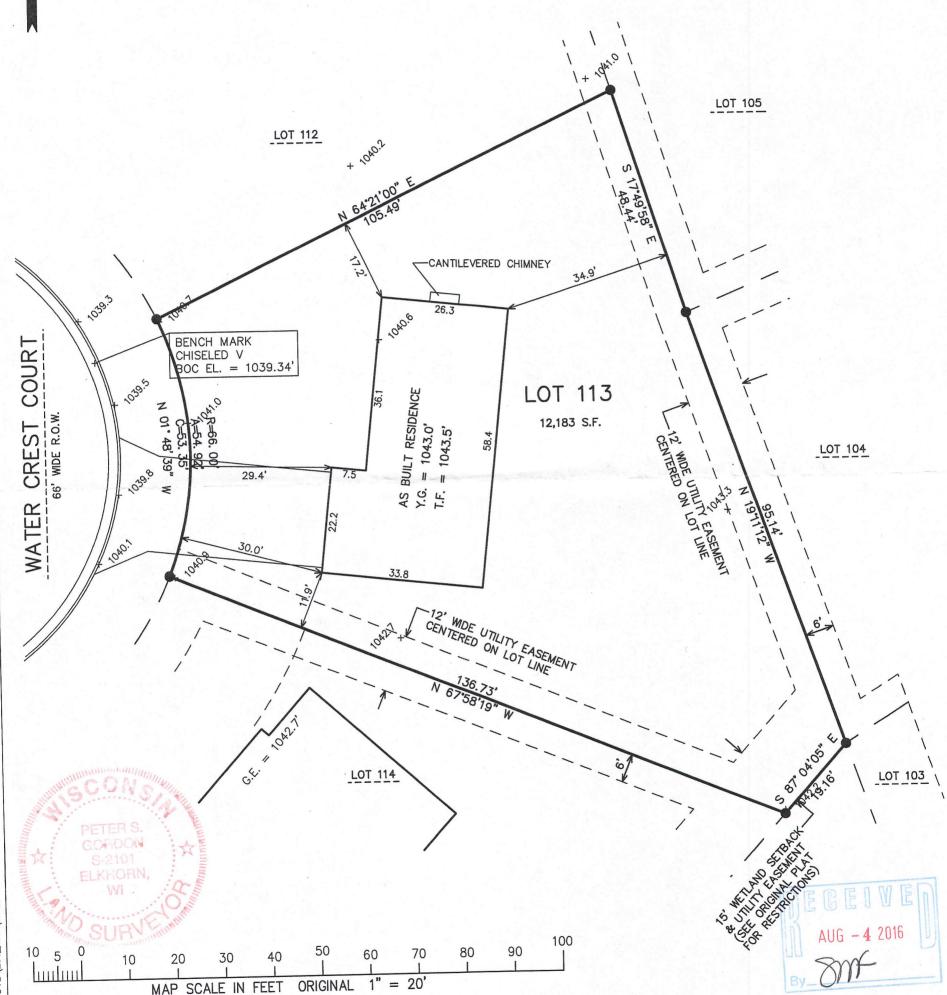

NOTE: COPIES OF THIS MAP TO WHICH THE FOLLOWING CERTIFICATE WILL APPLY SHOW THE SURVEYOR'S ORIGINAL SEAL AND SIGNATURE IN RED INK. COPIES BY ANY OTHER MEANS MAY HAVE ALTERATIONS WHICH DO NOT REPRESENT THE SURVEYOR'S WORK PRODUCT.

I HEREBY CERTIFY THAT THE ABOVE DESCRIBED PROPERTY HAS BEEN SURVEYED UNDER MY DIRECTION AND THAT THE ABOVE MAP IS A TRUE REPRESENTATION THEREOF AND SHOWS THE SIZE AND LOCATION OF THE PROPERTY AND ITS EXTERIOR BOUNDARIES. THIS SURVEY IS MADE FOR THE USE OF THE PRESENT OWNERS OF THE PROPERTY, AND EXTERIOR BOUNDARIES. ALSO THOSE WHO PURCHASE, MORTGAGE, OR GUARANTEE THE TITLE THERETO WITHIN ONE YEAR FROM THE DATE

SEPTEMBER 12, 2005 DATED: _

SUBDIVISION PLAT BEARING BASIS

REVISED 04-05-2016 TO SHOW SIZE & LOCATION OF AS BUILT RESIDENCE

PROJECT: 6103.02.113 DATE: 09/12/2005 SHEET 1 OF 1

LEGEND

(XXX) = RECORDED AS

= SET IRON REBAR STAKE = FOUND IRON PIPE STAKE

PETER S. GORDON R.L.S. 2101

X:\Projects\6103\ADD_2_INDV_LOTS\Lot_113\Lot_113

4/5/2016