


O - INDICATES IRON STAKE

DESCRIPTION: Commencing at an iron stake in the east line of Lincoln Street that is 563.40 feet North of the intersection of said east line and the south line of the NW  $\frac{1}{4}$  of Section 31, Town 3 North, Range 17 East, in the City of Elkhorn, Walworth County, Wisconsin; thence North 96.60 feet to an iron stake, thence East 150.00 feet to an iron stake, thence south 96.60 feet to an iron stake, thence West 150.00 feet to the place of beginning.

CERTIFICATE: I James F. Biagi do hereby certify that I have surveyed the property hereon described on this 4th day of April 1960.

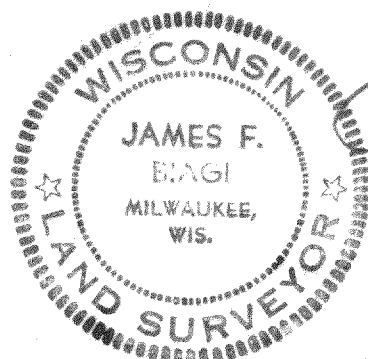

*James F. Biagi*  
James F. Biagi (RLS 272)