Plat of Survey

Lot 2 in Block 8 of Elkhorn Estates,

a subdivision located in the Southwest 1/4 of Section 1, Town 2 North, Range 16 East, City of Elkhorn, Walworth County, Wisconsin.

Surveyed for: Keefe Real Estate, Inc.

204 East Commerce Court Elkhorn, Wisconsin. 53121



Bearings reference to the South line of Sunnyside Drive, recorded as S89°10'33"E on the plat of Elkhorn Estates

Scale in Feet 1" = 20'

h Wisconsin Street * Telephone: (262) 72 Email: 1

♦♦⊠○

Reference Nun 2016.106

Job

2016.106


Road Marsh

MAR 9 2017

SCONS S-2093 ELKHORN, Stamped in Red.

Notes:

- This survey plat is not certified unless signed and sealed in red ink.
- 2) This survey is subject to Wisconsin lien laws. This Plat of Survey is the notice of intent to file lien. Lien waiver required.

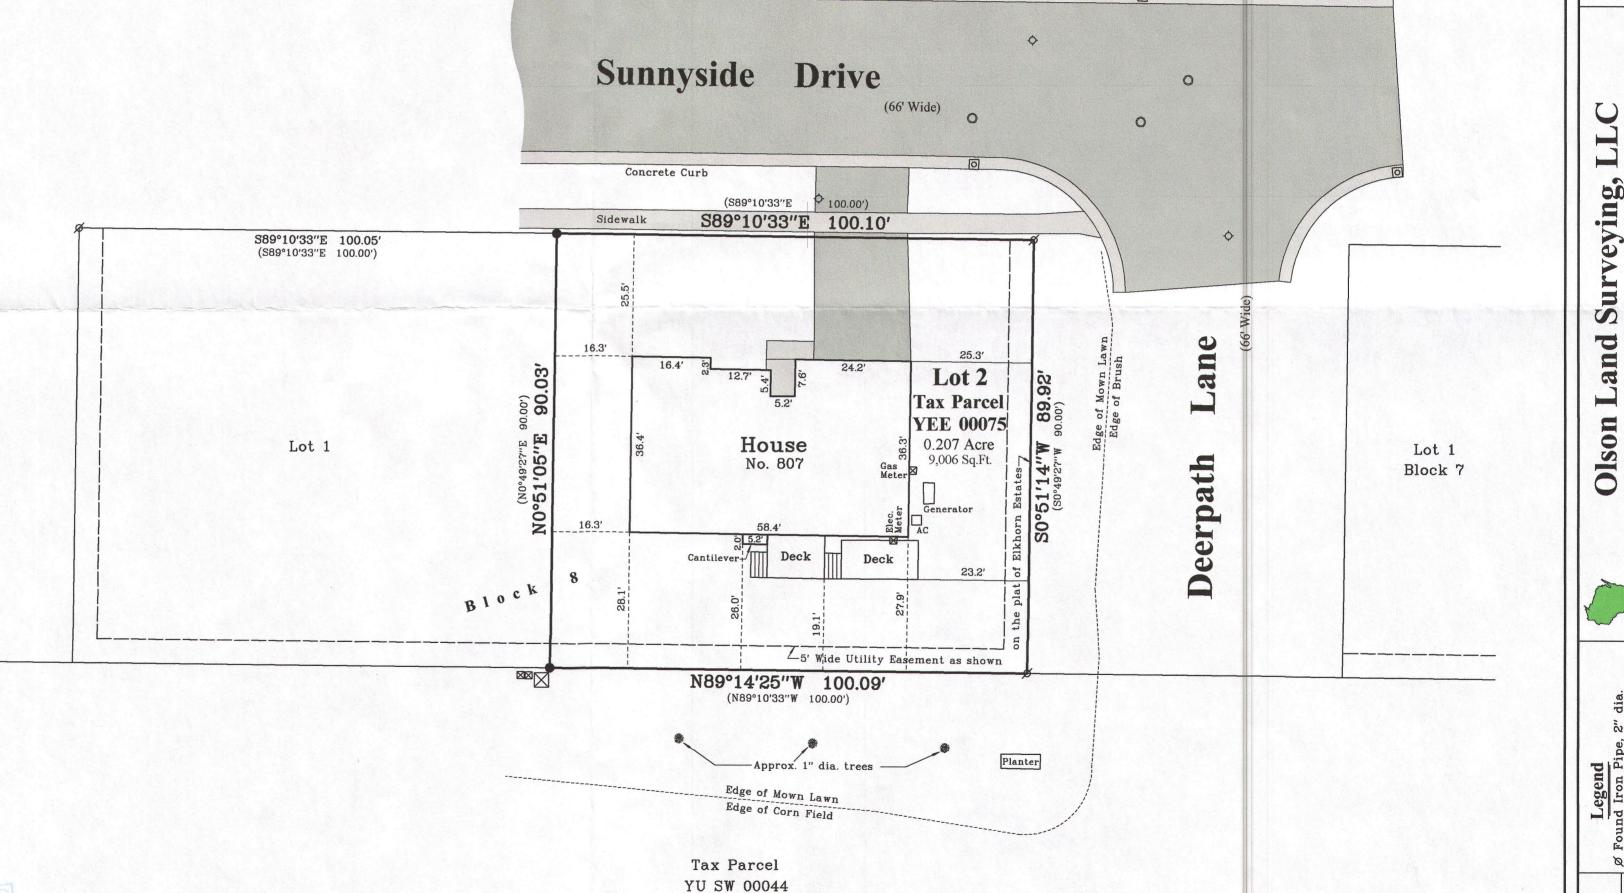

Copyright 2016 by Olson Land Surveying, LLC.

All rights reserved. No part of this survey plat may be reproduced or transmitted in any form by any means - graphic, electronic, or mechanical, including photocopying, tracing, or information storage and retrieval systems - without permission in writing from Douglas G. Olson, Olson Land Surveying, LLC.

I hereby certify that I have surveyed the above described property and the map hereon is correct to the best of my professional knowledge and belief and shows the size and location of the property, its exterior boundaries, the location and dimensions of all visible structures thereon, boundary fences, apparent easements and roadways and

visible encroachments, if any.

This survey is made for the exclusive use of the present owners of the property, and also those who purchase, mortgage or guarantee title thereto, within one year from the date hereof.

Douglas G. Olson

Wisconsin Professional Land Surveyor - 2093