


PLAT OF SURVEY LOT 2 OF CERTIFIED SURVEY MAP NO. 2324

LOCATED IN PART OF THE SW 1/4 OF THE NW 1/4
OF SECTION 36, TOWN 3 NORTH, RANGE 16 EAST,
CITY OF ELKHORN, WALWORTH COUNTY, WISCONSIN

ASSIGNED N. LINE OF LOT 2
S 81°20'35" E

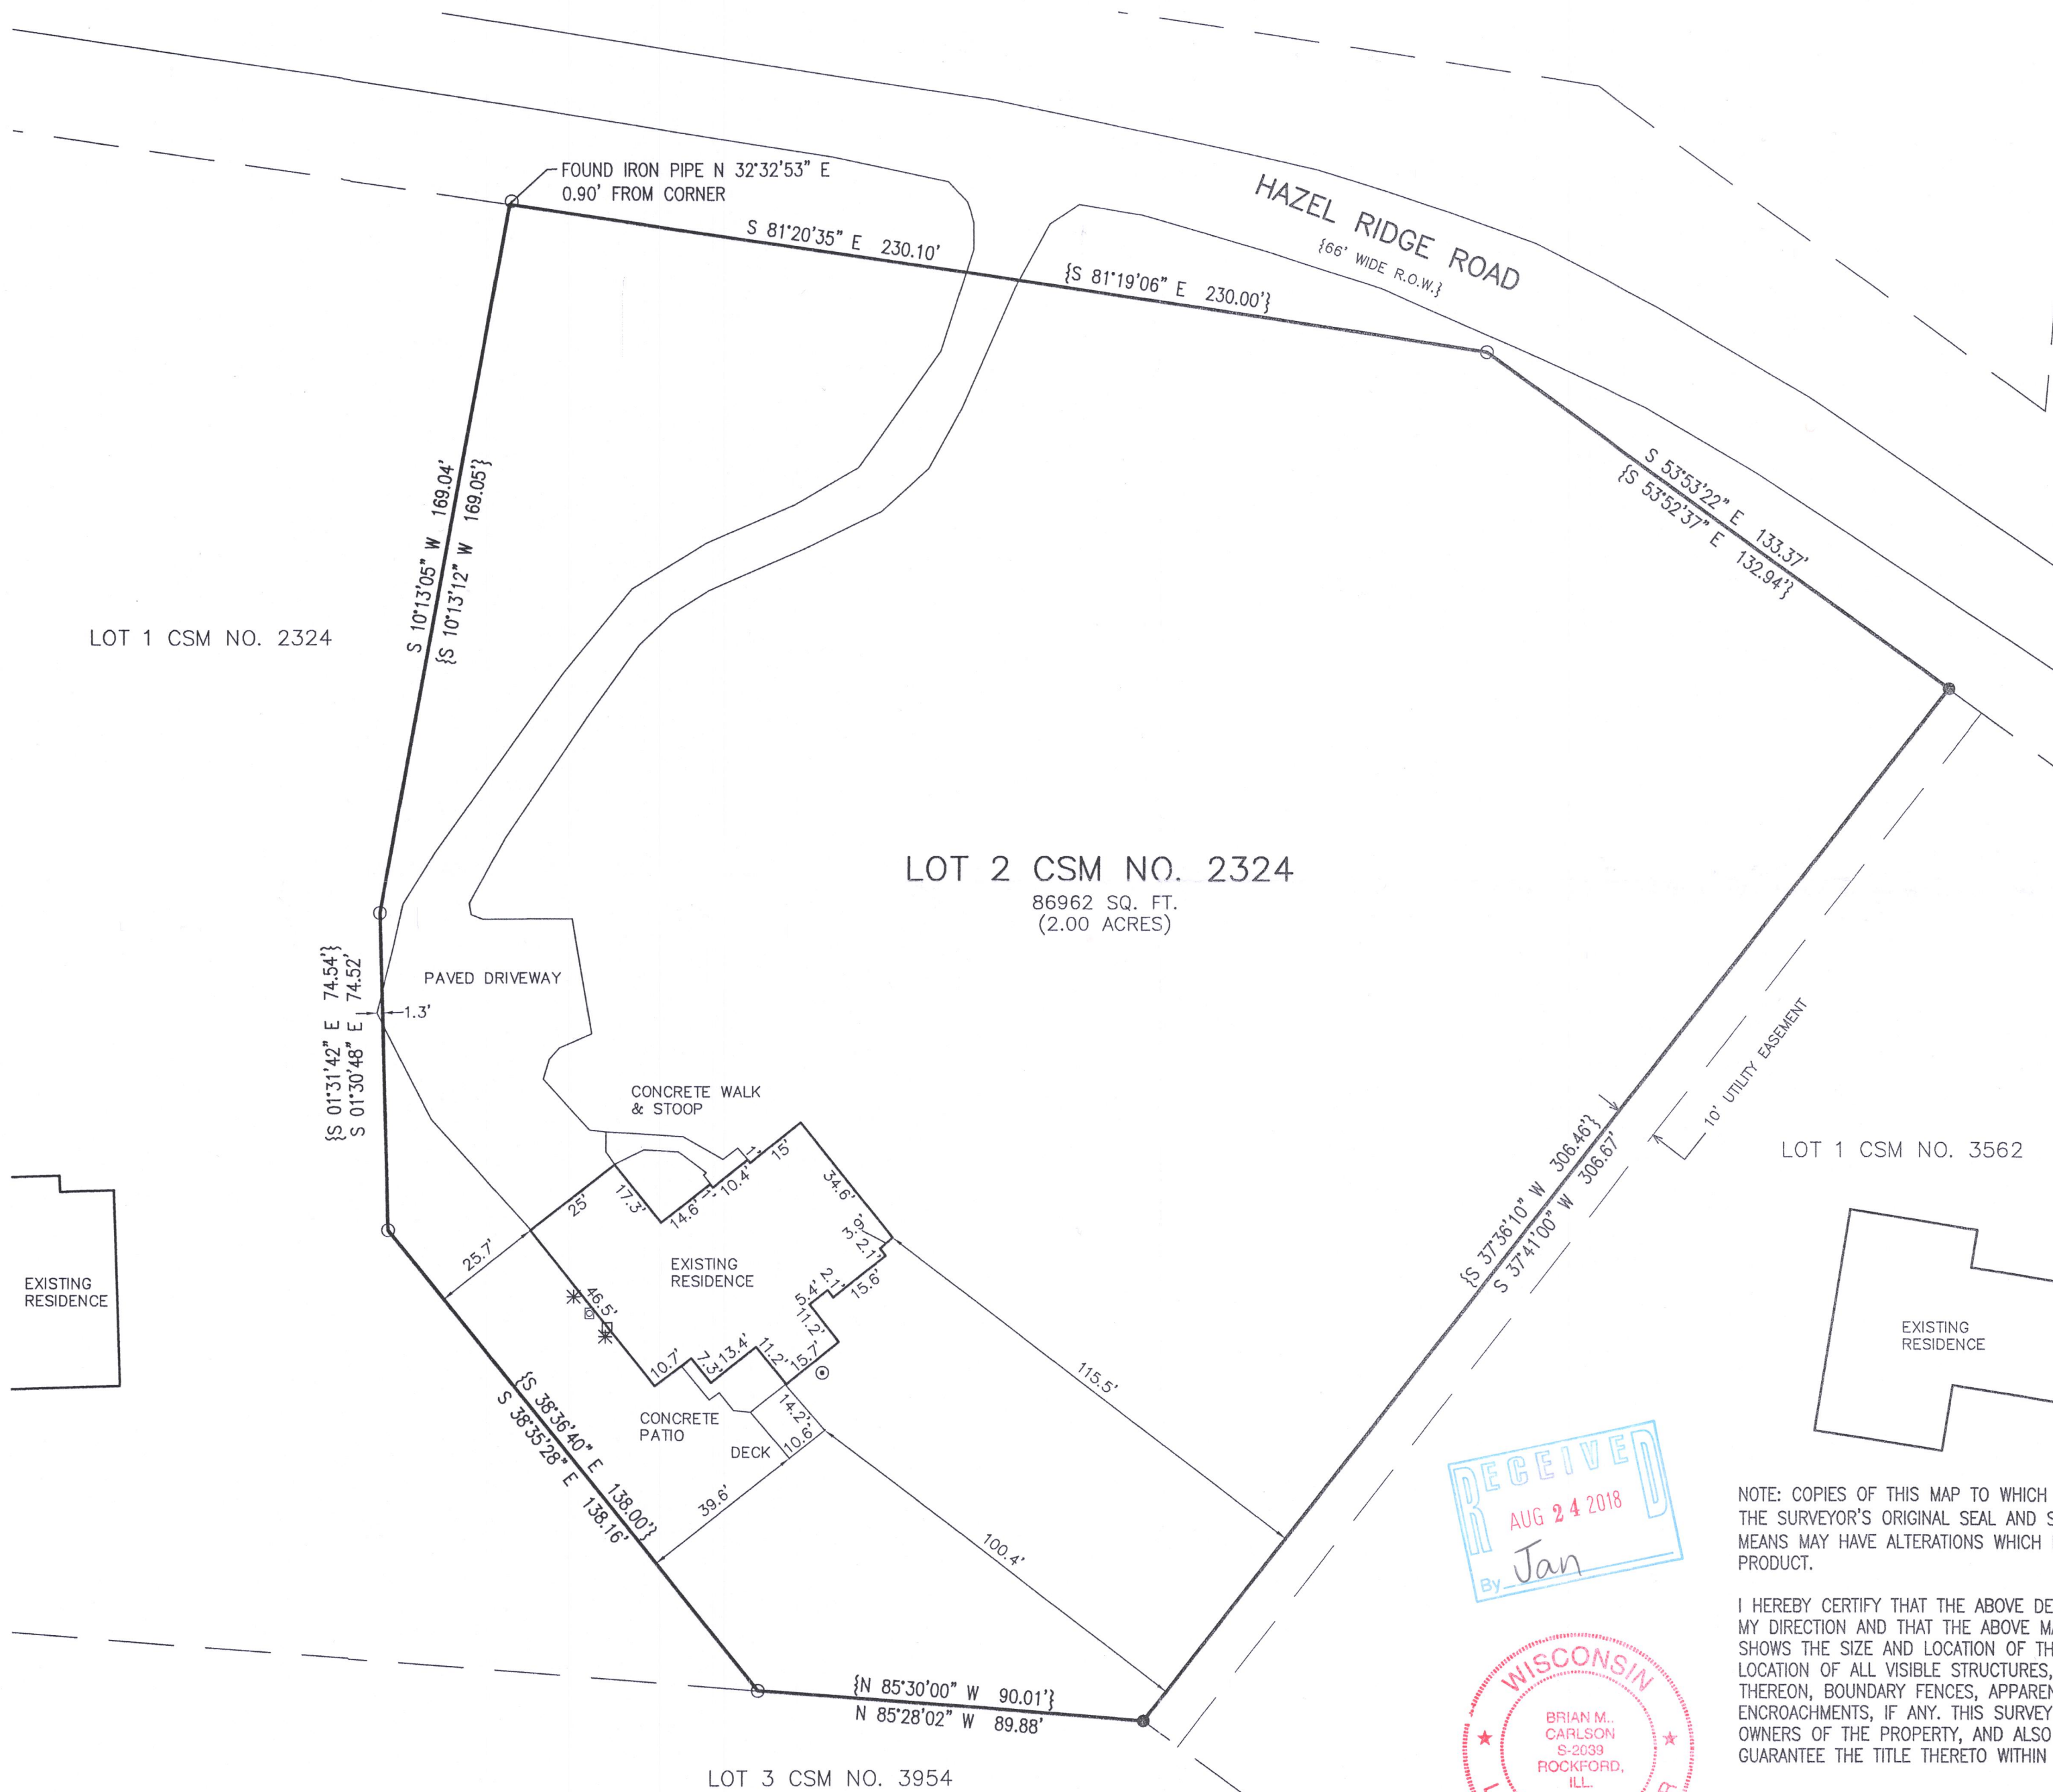

LEGEND

- = FOUND IRON REBAR STAKE
- = FOUND IRON PIPE
- * = AIR CONDITIONING UNIT
- = ELECTRIC METER
- ⊠ = GAS METER
- ⊙ = SANITARY CLEAN OUT
- {XXX} = RECORDED AS

NOTE: COPIES OF THIS MAP TO WHICH THE FOLLOWING CERTIFICATE WILL APPLY SHOW THE SURVEYOR'S ORIGINAL SEAL AND SIGNATURE IN RED INK. COPIES BY ANY OTHER MEANS MAY HAVE ALTERATIONS WHICH DO NOT REPRESENT THE SURVEYOR'S WORK PRODUCT.

I HEREBY CERTIFY THAT THE ABOVE DESCRIBED PROPERTY HAS BEEN SURVEYED UNDER MY DIRECTION AND THAT THE ABOVE MAP IS A TRUE REPRESENTATION THEREOF AND SHOWS THE SIZE AND LOCATION OF THE PROPERTY, ITS EXTERIOR BOUNDARIES, THE LOCATION OF ALL VISIBLE STRUCTURES, AND DIMENSIONS OF ALL PRINCIPLE BUILDINGS THEREON, BOUNDARY FENCES, APPARENT EASEMENTS, ROADWAYS, AND VISIBLE ENCROACHMENTS, IF ANY. THIS SURVEY IS MADE FOR THE USE OF THE PRESENT OWNERS OF THE PROPERTY, AND ALSO THOSE WHO PURCHASE, MORTGAGE, OR GUARANTEE THE TITLE THERETO WITHIN ONE YEAR FROM THE DATE HEREOF.

DATED: 08/08/2018

BRIAN M. CARLSON P.L.S. 2039



PLAT OF SURVEY
901 W. HAZEL RIDGE ROAD
ELKHORN, WI 53121

WORK ORDERED BY -
BETH WELTER
N8188 HIGH RIDGE DRIVE
ELKHORN, WI 53121

FARRIS, HANSEN & ASSOCIATES, INC.

ENGINEERING - ARCHITECTURE - SURVEYING
7 RIDGWAY COURT P.O. BOX 437
ELKHORN, WISCONSIN 53121
OFFICE: (262) 723-2098 FAX: (262) 723-5886

REVISIONS

PROJECT NO.
3475.18
DATE:
08/08/2018
SHEET NO.
1 OF 1

X:\PROJECTS\3475\3475_18\ACAD\3475-18.DWG