

PLAT OF SURVEY -OF-

LOT 9 IN BLOCK 4 OF FAIRLANE SUBDIVISION ADDITION NO. 1, BEING A SUBDIVISION OF A PART OF THE SOUTHWEST 1/4 OF THE NORTHWEST 1/4 OF SECTION 31, TOWNSHIP 3 NORTH, RANGE 17 EAST OF THE FOURTH PRINCIPAL MERIDIAN, IN THE CITY OF ELKHORN, COUNTY OF WALWORTH AND STATE OF WISCONSIN.

SURVEY FOR: ERIC THOMPSON

SURVEY ADDRESS: 426 SANDY LANE, ELKHORN, WI 53121

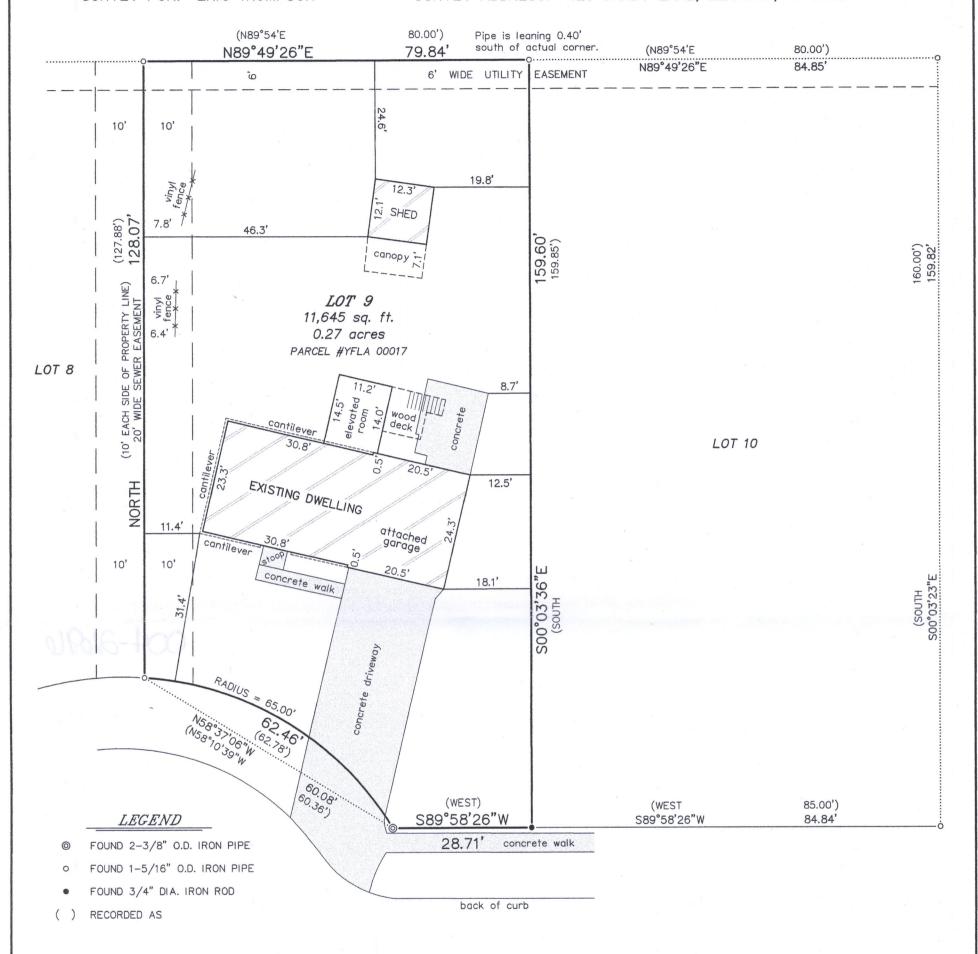

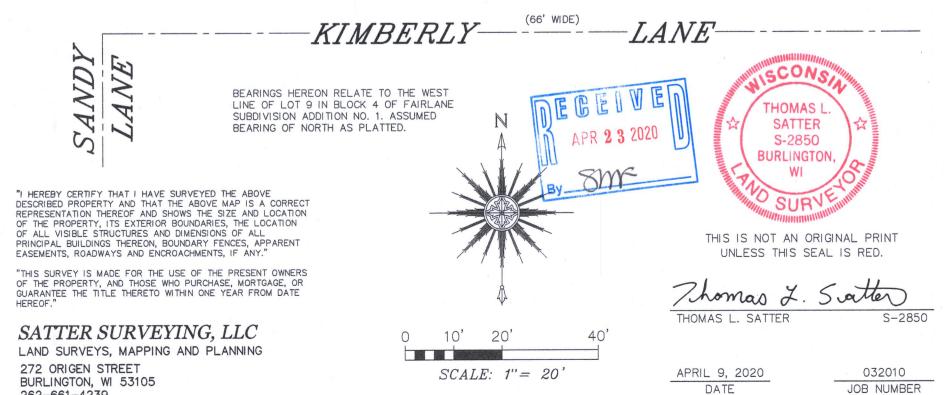

YFLA-17

262-661-4239

004-2696