


#83-69

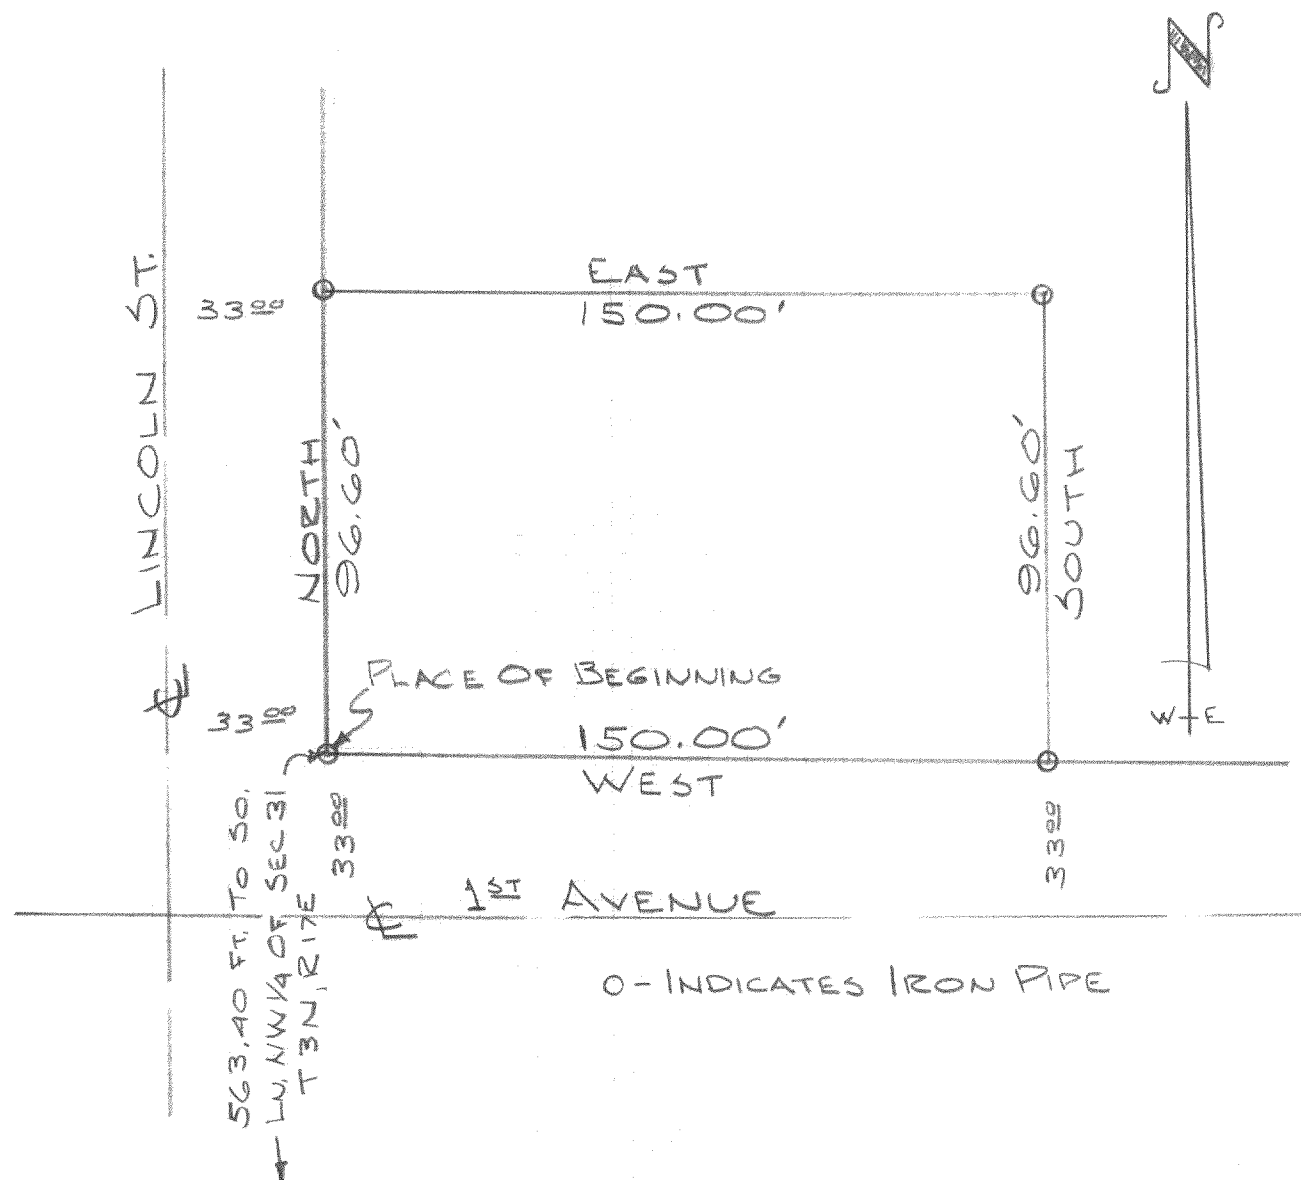


DESCRIPTION: Commencing at an iron stake in the east line of Lincoln Street that is 563.40 feet North of the intersection of said east line and the south line of NW $\frac{1}{4}$ of Section 31, Town 3 north, Range 17 east, in the City of Elkhorn, Walworth County, Wisconsin; thence North 96.60 feet to an iron stake, thence East 150.00 feet to an iron stake, thence South 96.60 feet to an iron stake, thence West 150.00 feet to the place of beginning.

CERTIFICATE: I, James F. Biagi do hereby certify that I have surveyed the property hereon described.

Dated this eleventh day of June 1969.

James F. Biagi. RLS 272
Elkhorn, Wisconsin.

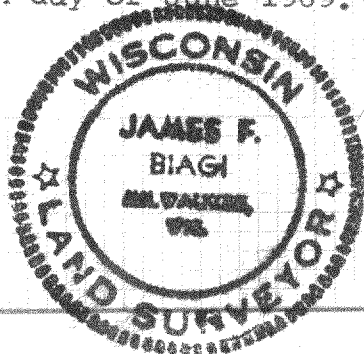

U-NE-7H

307 4-270