
FARRIS. HANSEN & COOPER. INC.

ENGINEERING, SURVEYING AND LAND PLANNING 715 W. WALWORTH ST. - P.O. BOX 487 - ELKHORN, WI 53121 OFFICE: 414/723-2098

MORTGAGE INSPECTION SURVEY

NOTE: THIS IS NOT A "PROPERTY SURVEY" AS DEFINED IN SEC. 5.01 OF THE WIS. ADMIN. CODE.

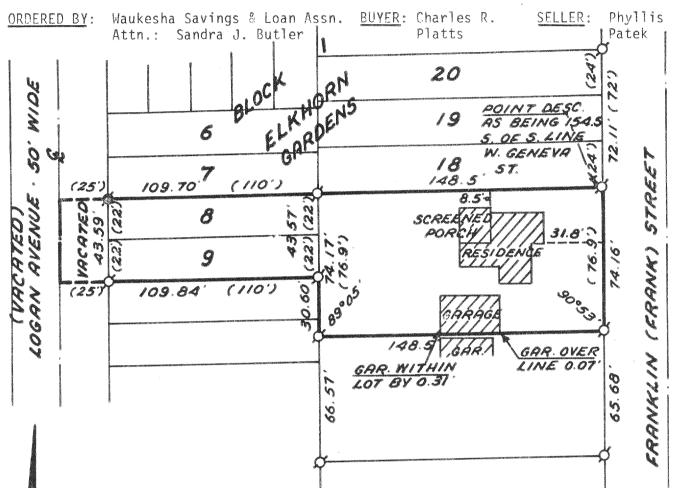

DESCRIPTION: Beginning on the W. line of Franklin Street, also known as Frank Street, in the City of Elkhorn, 154.5 feet S. of the S. line of West Geneva Street; thence S. 76.9 feet; thence W. 148.5 feet; thence N. 76.9 feet; thence E. 148.5 feet to the place of beginning. Also, Lots 8 and 9 in Block 1 of Elkhorn Gardens, a subdivision lying and being in the City of Elkhorn, Walworth County, Wisconsin, according to a plat thereof on record in the office of the Register of Deeds in and for the County of Walworth and State of Wisconsin. Also, the East 25 feet of vacated Logan Avenue adjoining the West lines of said Lots 8 and 9 in Block 1 of Elkhorn Gardens.

SCALE: 1':50'

LEGEND

∅—Iron Rod Found 🕏

()—Record Dimension

I hereby certify true and accurate representation the lot lines as found to be monumented and the location of the buildings located thereon to the best of my knowledge and

Daniel D. Cooper RLS

2 Date

DRAWING NUMBER 1429