


PLAT OF SURVEY
-OF-

LOT 8, BLOCK 1, ELKHORN ESTATES, LOCATED IN
SECTION 1, TOWN 2 NORTH, RANGE 16 EAST, IN THE
CITY OF ELKHORN, WALWORTH COUNTY, WISCONSIN.

SURVEY FOR: JACK BAKER; COLDWELL BANKER

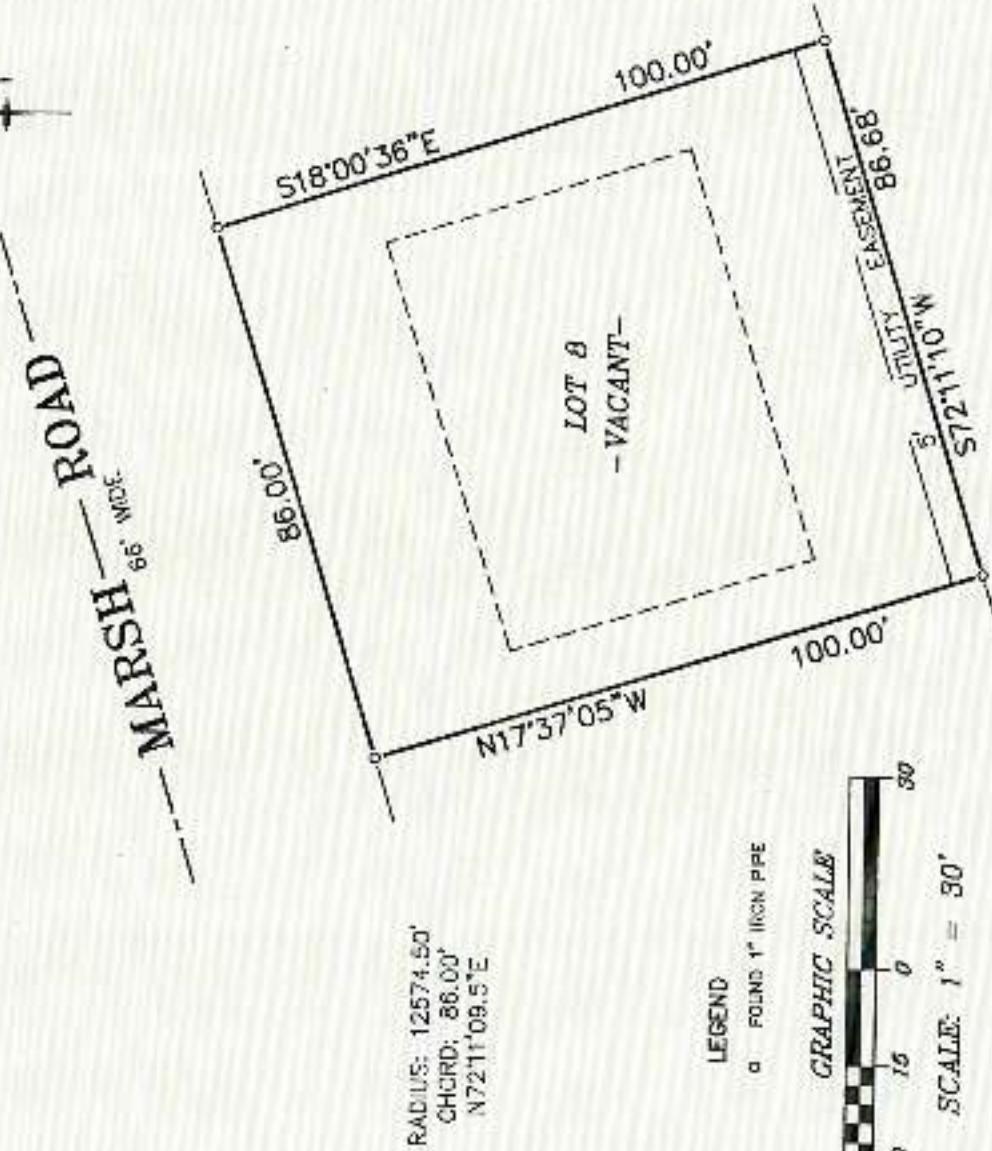

WARNINGS HEREBE I HAVE SURVEYED THE ABOVE DESCRIBED
PROPERTY AND THAT THE ABOVE MAP IS A CORRECT REPRESENTATION THEREOF
ASSUMED BEARING NORTH 17°37'05" WEST.

REFER TO A CURRENT TITLE REPORT FOR EASEMENTS AND
RESTRICTIONS WHICH MAY AFFECT THE USE OF THIS SITE.

I hereby certify that I have surveyed the above described
property and that the above map is a correct representation thereof
and shows the size and location of the property, its exterior
boundaries, the location of all visible structures and dimensions
of all principal buildings thereon, boundary fences, apparent
easements, roadways and encroachments, if any.

*This survey is made for the use of the present owner or
property and those who purchase, mortgagor, or
title thereto within one year from date hereof.



THIS IS NOT AN ORIGINAL PRINT
UNLESS THIS SEAL IS READ.

B.W. SURVEYING, INC.

412 N. PINE STREET
BURLINGTON, WI 53105
(262)-787-0225

JANUARY 20, 2021
DATE
10296 - 18
JOB NUMBER