


**PLAT OF SURVEY
-OF-**

LOT 13, BLOCK 1, ELKHORN ESTATES, LOCATED IN
SECTION 1, TOWN 2 NORTH, RANGE 16 EAST, IN THE
CITY OF ELKHORN, WALWORTH COUNTY, WISCONSIN.

SURVEY FOR: JACK BAKER; COLDWELL BANKER

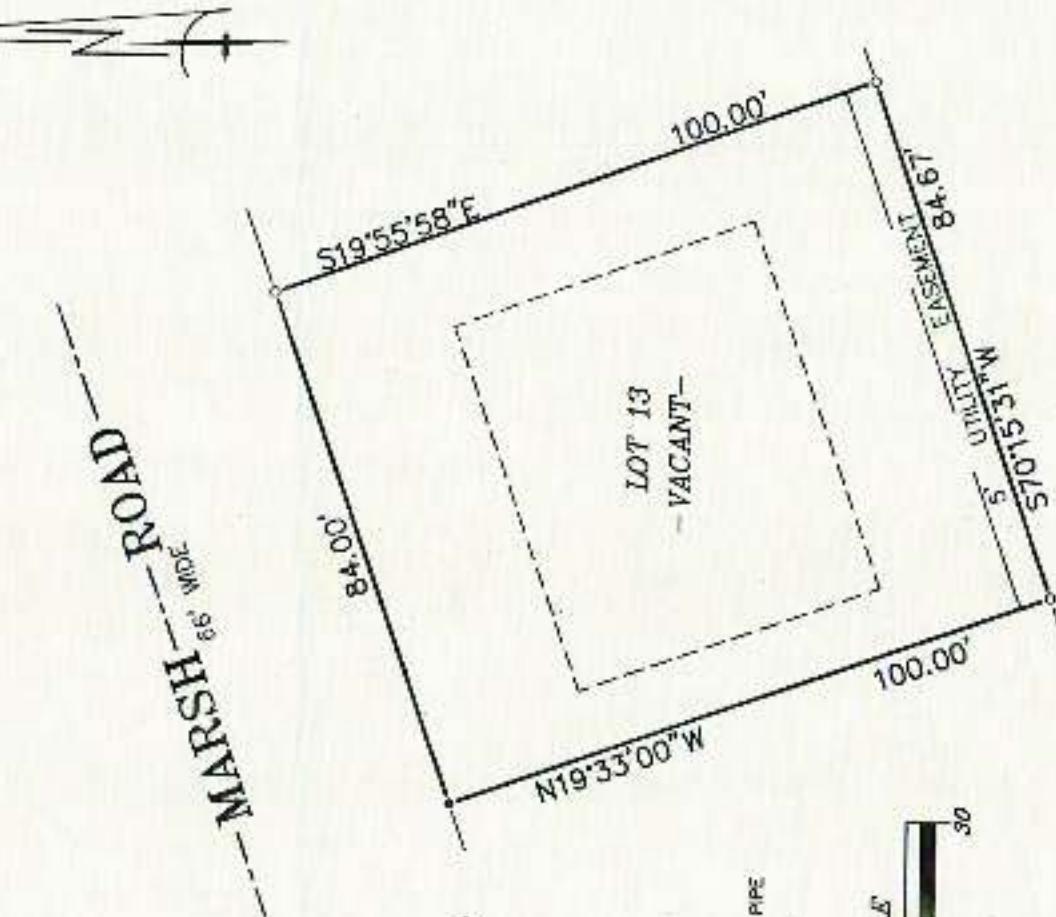

RADIUS: 12574.50'
CHORD: 84.00'
N70°15'31"E

LEGEND

- FOUND 1" IRON PIPE
- SET IRON PIPE

GRAPHIC SCALE



BEARINGS REFERRED RELATE TO THE WEST LINE OF LOT 13,
ASSUMED BEARING NORTH 19°33'00" WEST.

REFER TO A CURRENT TITLE REPORT FOR EASEMENTS AND
RESTRICTIONS WHICH MAY AFFECT THE USE OF THIS SITE.

"I hereby certify that I have surveyed the above described
property and that the above map is a correct representation thereof
and shows the size and location of the property, its exterior
boundaries, the location of all visible structures and dimensions
of all principal buildings thereon, boundary fences, apparent
easements, roadways and encroachments, if any.

This survey is made for the use of the present owners of the
property, and those who purchase, mortgage, or guarantee it or
title thereto within one year from date hereof.



THIS IS NOT AN ORIGINAL PRINT
UNLESS THIS SEAL IS RED.

B. W. SURVEYING, INC.



412 N. PINE STREET
BURLINGTON, WI 53105
(262)-767-0225

ROBERT J. WEZEL
S-1778

JANUARY 20, 2021

DATE

10296 - L13

JOB NUMBER