


Plat of Survey

of

Lot 1 in Block 38 of Davis Addition  
to the Village (now City) of Elkhorn,

a subdivision located in the Southeast 1/4 of the Northeast 1/4 of Section 36,  
Town 3 North, Range 16 East, City of Elkhorn, Walworth County, Wisconsin.

Surveyed for: **Ken Woroniecki**  
328 North Broad Street  
Elkhorn, Wisconsin. 53121

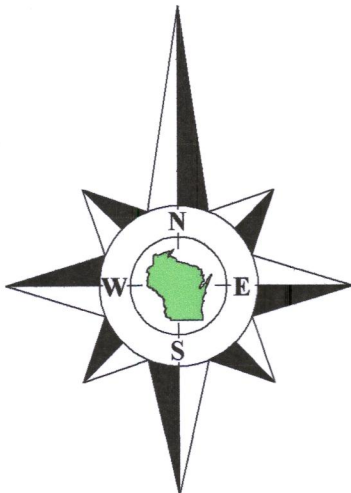

Bearings referenced to the West line  
of Broad Street, assumed as North  
as shown on prior surveys of record.



- Notes:**
- 1) This Plat of Survey is not certified unless signed and sealed in red ink.
  - 2) This survey is subject to Wisconsin lien laws. This Plat of Survey is the notice of intent to file lien. Lien waiver required.
  - 3) The Survey Date shown on this Plat of Survey is the completion date of the field work.



Copyright ©2021 by Olson Land Surveying, LLC.

All rights reserved. No part of this survey plat may be reproduced or transmitted in any form by any means - graphic, electronic, or mechanical, including photocopying, tracing, or information storage and retrieval systems - without permission in writing from Douglas G. Olson, Olson Land Surveying, LLC.


I hereby certify that I have surveyed the above described property in compliance with Chapter A-E 7 of the Wisconsin Administrative Code and that the map hereon is correct to the best of my professional knowledge and belief and shows the size and location of the property, its exterior boundaries, the location and dimensions of all visible structures thereon, boundary fences, apparent easements and roadways and visible encroachments, if any.

This survey is made for the exclusive use of the present owners of the property, and also those who purchase, mortgage or guarantee title thereto, within one year from the date hereof.

Douglas G. Olson  
Wisconsin Professional Land Surveyor - 2093

Survey Date: May 6, 2021.

Revisions:

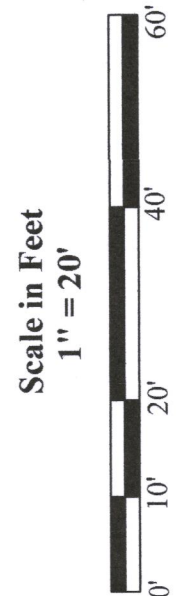

45 South Wisconsin Street | P.O. Box 322  
Elkhorn, Wisconsin. 53121  
Telephone: (262) 723-3434  
Facsimile: (262) 723-8044  
Email: doug@olsonsurveying.com  
Website: www.olsonsurveying.com

**OLSON**  
LAND SURVEYING, LLC  
Rural | Residential | Commercial

**Legend of Symbols & Abbreviations**

Found Concrete Monument	North Arrow
Found Iron Pipe	Set Iron Pipe, 1" dia.
Found Iron Rod	Recorded Information
Set Iron Pipe, 1" dia.	Utility Pole
Recorded Information	Hydrant
Utility Pole	Catch Basin
Hydrant	Water Valve
Catch Basin	Manhole
Water Valve	Concrete Surface
Manhole	Asphalt Surface
Concrete Surface	
Asphalt Surface	

Sheet 1 of 1 Sheets

Job Reference Number

2021.042

2021.042