
PLAT OF SURVEY

OF THE NORTH LINE OF LOT 1 OF CERTIFIED SURVEY MAP No. 3696, RECORDED IN VOLUME 22, PAGES 107 - 109, LOCATED IN THE NORTHWEST 1/4 OF THE NORTHWEST 1/4 OF SECTION 7, TOWNSHIP 2 NORTH, RANGE 17 EAST, OF THE 4TH P.M., CITY OF ELKHORN, WALWORTH COUNTY, WISCONSIN.

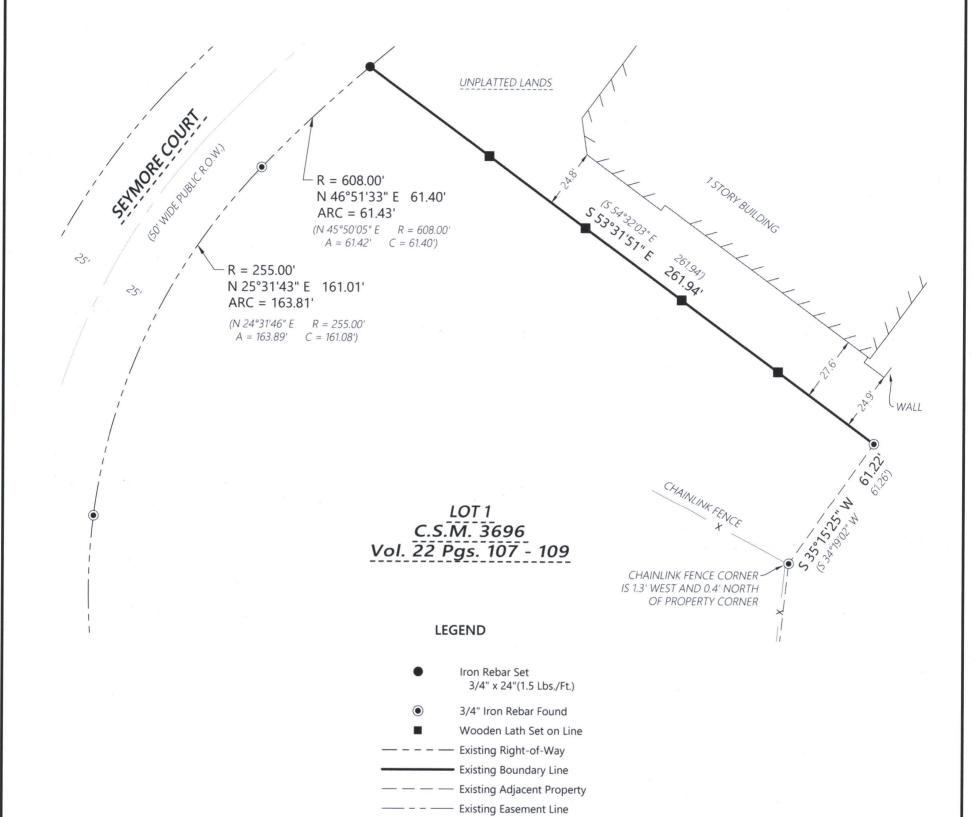

Existing Centerline Existing Fence

Record Information



Kristm J Belong

Kristin J. Belongia, P.L.S. Wisconsin Professional Land Surveyor S-2943

State of Wisconsin County of Rock } ss

If the surveyor's signature is not red in color, the plan is a copy that should be assumed to contain unauthorized alterations. The certification contained on this document


(XXX.XX)

shall not apply to any copies.

The property described above and to the best

I hereby certify that I have supervised the survey of the property described above and to the best my knowledge and belief, the plat drawn hereon complies with Chapter A-E 7 of the State of Wisconsin Administrative Code, Minimum Standards for Property Surveys and correctly represents said survey and its location.

Given under my hand and seal this 9th day of November, 2021 at Beloit, Wisconsin. Last day of field work November 8th, 2021

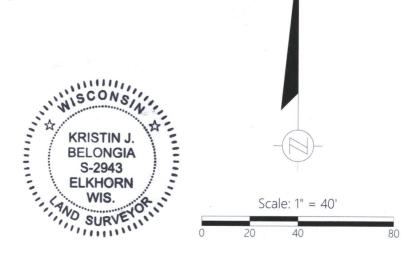

DISTANCE UNITS BASED ON THE UNITED STATES SURVEY FOOT

BEARINGS BASED ON THE WISCONSIN COORDINATE REFERENCE SYSTEM, WALWORTH ZONE. THE NORTH PROPERTY LINE HAVING A BEARING OF S 53°31'51" E

www.rhbatterman.com

ORDER NO: 34111

FIELD CREW: BMR DRAWN BY: BMR FOR THE EXCLUSIVE USE OF: Lakelands Little Learners 240 Commerce Court Elkhorn, WI 53121

PLAT OF SURVEY

Batterman
engineers surveyors planners
2857 Bartells Drive Beloit, Wisconsin 53511

3