


I CERTIFY THAT I HAVE SURVEYED THE
BELOW DESCRIBED PROPERTY AND THAT THE
PLAT SHOWN HEREON IS AN ACCURATE
SURVEY & A TRUE REPRESENTATION
THEREOF & CORRECTLY SHOWS THE
BOUNDARY LINES OF SAID PROPERTY
AND ALL BUILDINGS THEREON.

MAY 9 1979

JENSEN SURVEYING & MAPPING
ELKHORN WISCONSIN

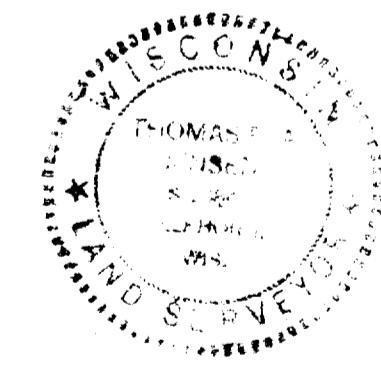

NOTE: ORIGINAL PLAT ON RECORD
SHOWS BLK 10 AS BEING 495'
NORTH & SOUTH AND 264' EAST
ANOMEST WITH THE LOTS BEING
132' x 82.5' — MR. TUBBS AS
CITY ENG. RESURVEYED ELKHORN
AND FOUND THE OVERRUN AND
UNDERUN IN THE BLOCKS AND
RECORDED THE MEAS. IN THE
CITY ENG. RECORDS.

NOTE: LOT 6 BLK 10 O.R. ADDRESSES TO
HAVE BEEN SURVEYED PREVIOUSLY AND
THE SURVEYOR MONUMENTED THE LOT
USING THE "ON RECORD" DISTANCES
AND PUTTING THE BLK OVERRUN
INTO THE NORTH & LOTS OF THE
BLK DISREGARDING TUBBS RECORDS
IN THE CITY OFFICE.

OVERSEEN FOR: Lyle Schmitke, ELKHORN, WIS

PLAT OF SURVEY OF

LOT 6 BLOCK 10 ORIGINAL PLAT TO THE
CITY OF ELKHORN, WIS. CO. WIS.

Thomas P. Jensen
SIGNATOR

- ~ 1½" DIA. IRON BAR SET
- ~ 8" DIA. IRON BAR SET
- ~ 1" DIA. IRON PIPE FOUND
- F.I.P. ~ FOUND IRON PIPE
- () ~ CITY ENG. RECORDS BY TUBBS

SCALE 1" = 30'

DATE MAY 9, 1979