



ROBERS & BOYD, INC.
CONSULTING ENGINEERS
LAND SURVEYORS


109 SOUTH SPRING STREET
BURLINGTON, WISCONSIN 53105
PHONE: 414-763-7834

MORTGAGE INSPECTION
FOR
UNIVERSAL MORTGAGE CORPORATION
OF

Lot 8, Block 6, Edgewood Third Addition, located in the Northwest 1/4 of the Northeast 1/4 of Section 36, Town 3 North, Range 16 East, of the Fourth Principal Meridian, City of Elkhorn, Walworth County, Wisconsin.

Owner: Stephen & Sue Schiller
539 Sunset
Elkhorn, WI


NOTE: This Mortgage Inspection was prepared for identification purposes for a real estate sale transaction. No corners were set by request of Universal Mortgage Corporation. Do not use this map for establishing fence lines.

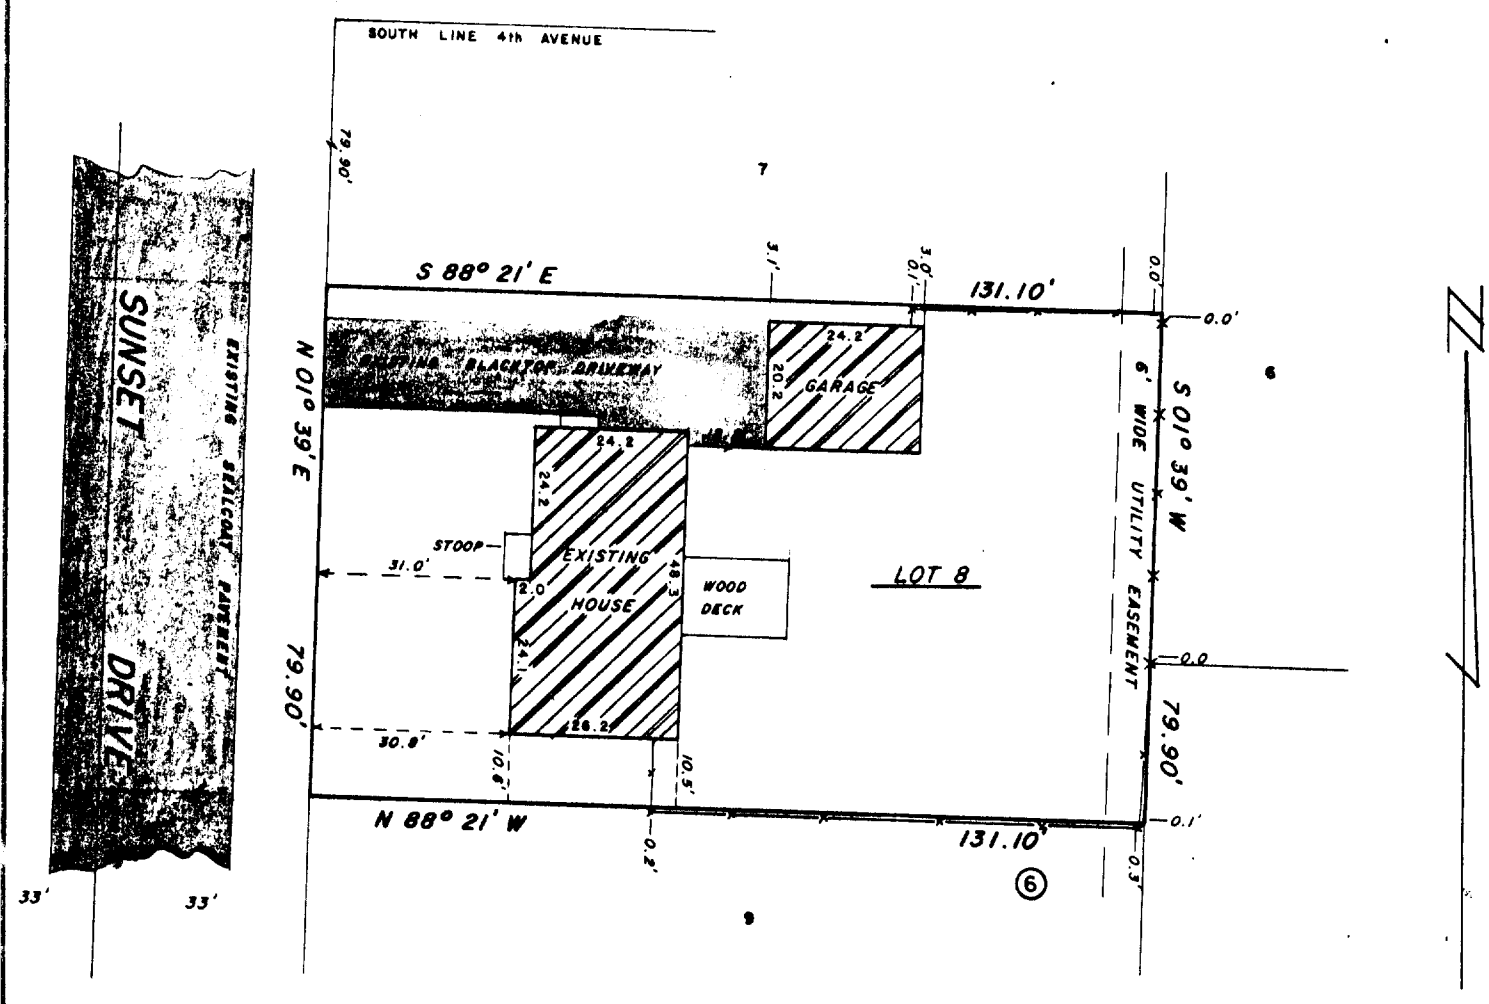

"I hereby certify that I have surveyed the above described property and that the above map is a true representation thereof and shows the size and location of the property, its exterior boundaries, the location of all visible structures and dimensions of all principal buildings thereon, boundary fences, apparent easements, roadways and visible encroachments, if any.

"This survey is made for the use of the present owners of the property, and also those who purchase, mortgage, or guarantee the title thereto within one year from date hereof."

YES - MONUMENTATION HAS BEEN WAIVED IN ACCORDANCE WITH A-E 5.01(b) OF THE WISCONSIN ADMINISTRATIVE CODE.

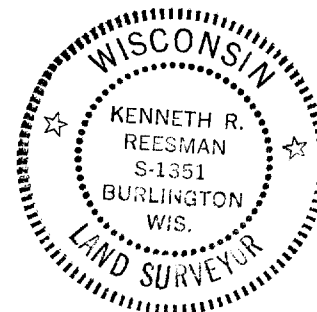

- LEGEND**
- + CHISEL CUT IN CONCRETE
 - o PK NAIL
 - FOUND IRON PIPE -
 - FOUND IRON PIPE -
 - SET IRON PIPE -
 - FOUND BRASS CAPPED MONUMENT
 - FOUND CONCRETE MONUMENT
 - FENCE - BOARD
 - () RECORDED AS
 - EXISTING GROUND ELEVATION

SCALE - 1" = 30'

Kenneth R. Reesman
WISCONSIN REGISTERED LAND SURVEYOR

11-8-82
DATE

82218
JOB NUMBER

KAE
VSA 3-11

4-314-R