

KOLB LAND CONSULTING, INC.

LAND SURVEYING . SUBDIVIDING . LAND PLANNING

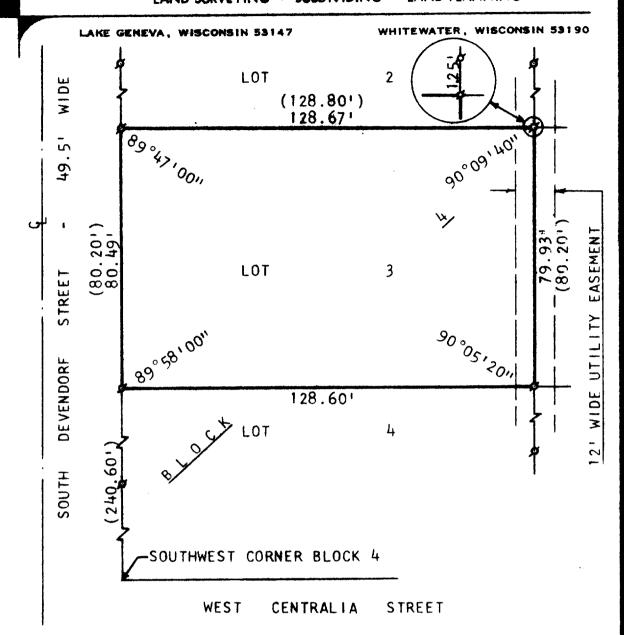

PLAT OF SURVEY OF

LOT 3, BLOCK 4, JAMES JONES 2ND ADDITION, CITY OF ELKHORN, WALWORTH COUNTY, WISCONSIN.

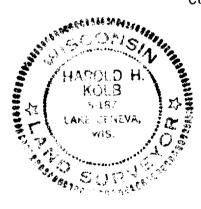

ORDERED BY: SORENSEN & JOHNSON CORPORATION 433 BROAD STREET LAKE GENEVA, WI 53147



SCALE: 1"=30' LEGEND

ø - IRON PIPE FOUNDo - IRON PIPE PLACED

() - AS PLATTED

I, HAROLD H. KOLB, DO HEREBY CERTIFY THAT I HAVE SURVEYED THE PROPERTY HEREON DESCRIBED ACCORDING TO THE OFFICIAL RECORDS, AND THAT THE PLAT HEREON IS A CORRECT REPRESENTATION OF THE LOT LINES TO THE BEST OF MY KNOWLEDGE AND BELIEF.

Hereb De Just

HAROLD H. KOLB WISCONSIN REGISTERED LAND SURVEYOR, S- 187

yJA2-52

4-325-K