

COOPER SURVEYING SERVICES


Rural - Residential - Commercial

DANIEL D. COOPER
Registered Land Surveyor

Route 3, Box 255 :: Elkhorn, Wisconsin 53121

Phone (414) 723-6265

SURVEYING & PLANNING
SUBDIVISIONS - LOT SURVEYS
CONSTRUCTION STAKING - MAPPING

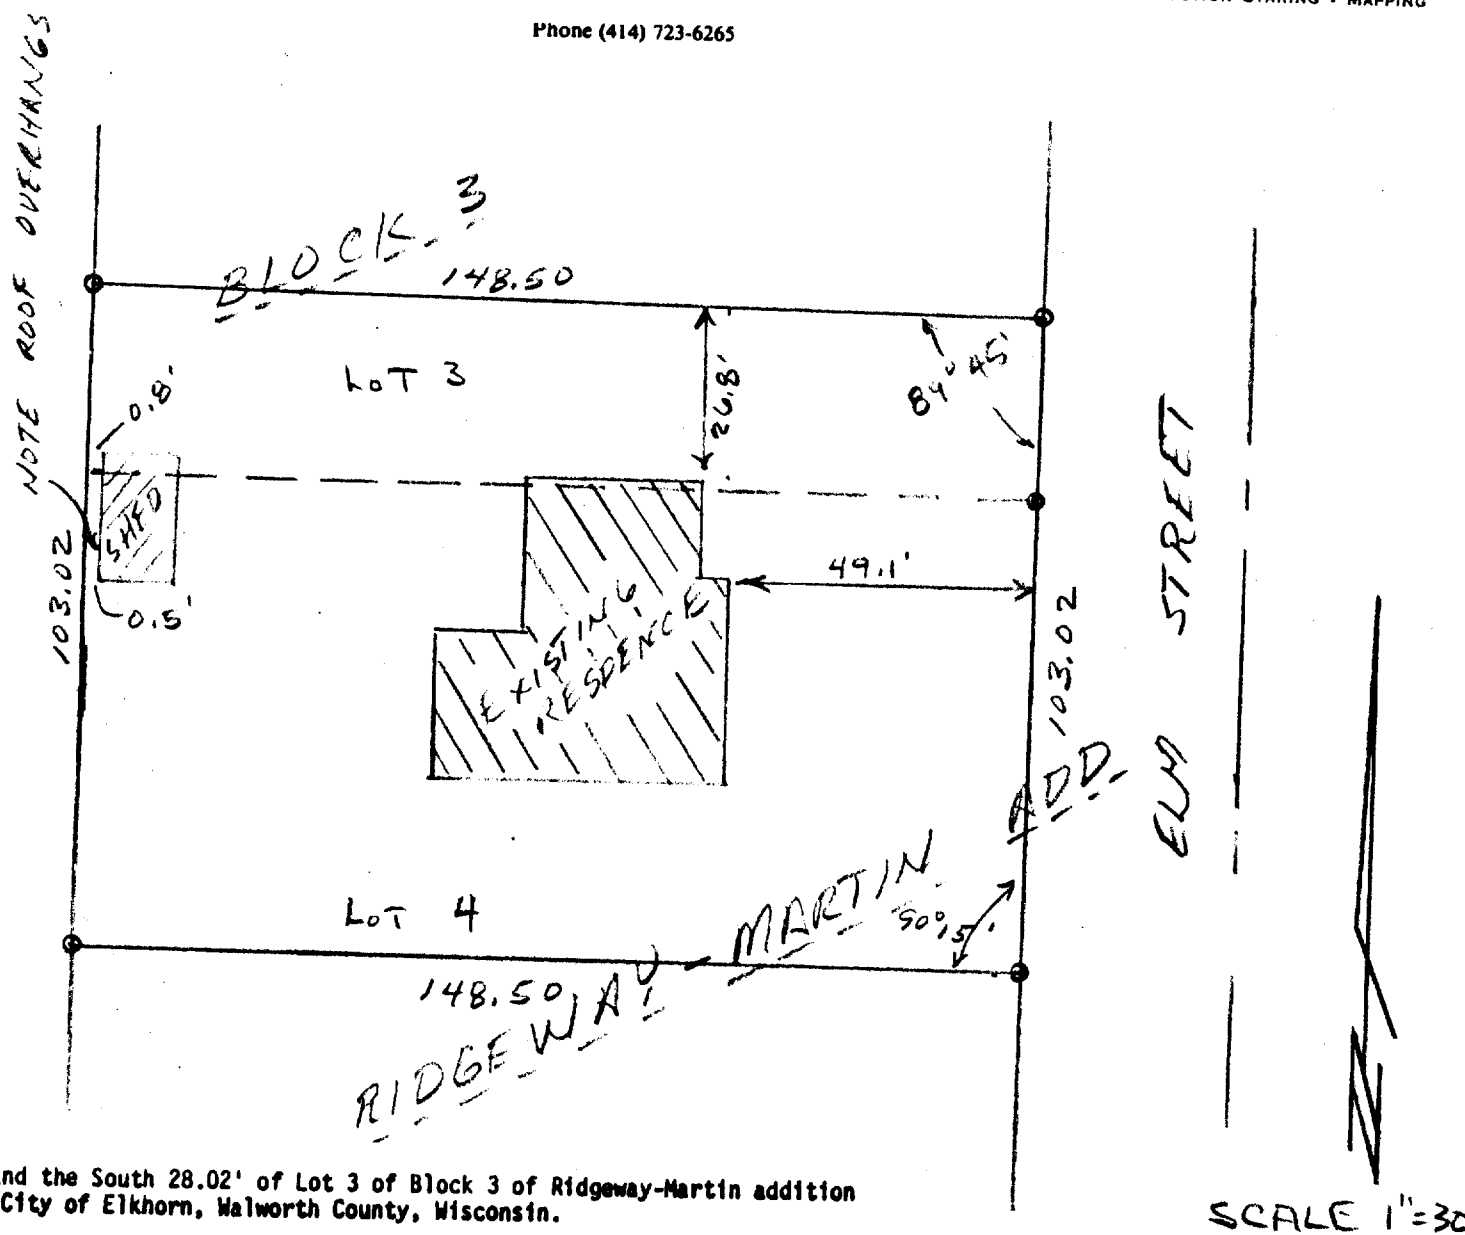


Lot 4 and the South 28.02' of Lot 3 of Block 3 of Ridgeway-Martin addition to the City of Elkhorn, Walworth County, Wisconsin.

I, DANIEL D. COOPER, REGISTERED SURVEYOR, DO HEREBY CERTIFY THAT I HAVE SURVEYED THE PROPERTY DESCRIBED HEREDON AND THAT THE MAP SHOWN HEREDON IS A TRUE AND ACCURATE REPRESENTATION THEROF TO THE BEST OF MY PROFESSIONAL KNOWLEDGE AND BELIEF.

DATED THIS 13 DAY OF MAR. 1984

Daniel D. Cooper
DANIEL D. COOPER, RLS NO. S-1464

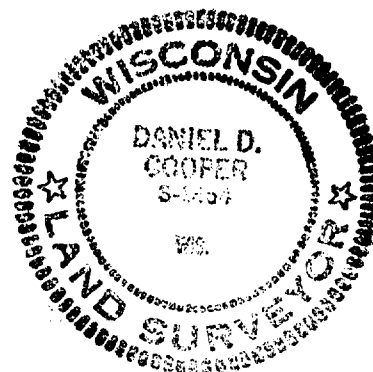

SURVEYED ORDERED BY--
MODERN REALTY

YRM-00021A

4-337-C ✓ DRAWING NO. 1910