


ROCKWELL STREET

卷之三


PLAT OF SURVEY - PART OF LOTS 2 & 3 BLK. 48 OF
ROCKWELL'S 2ND ADDITION, ELKHORN, WAL. CO., WIS.

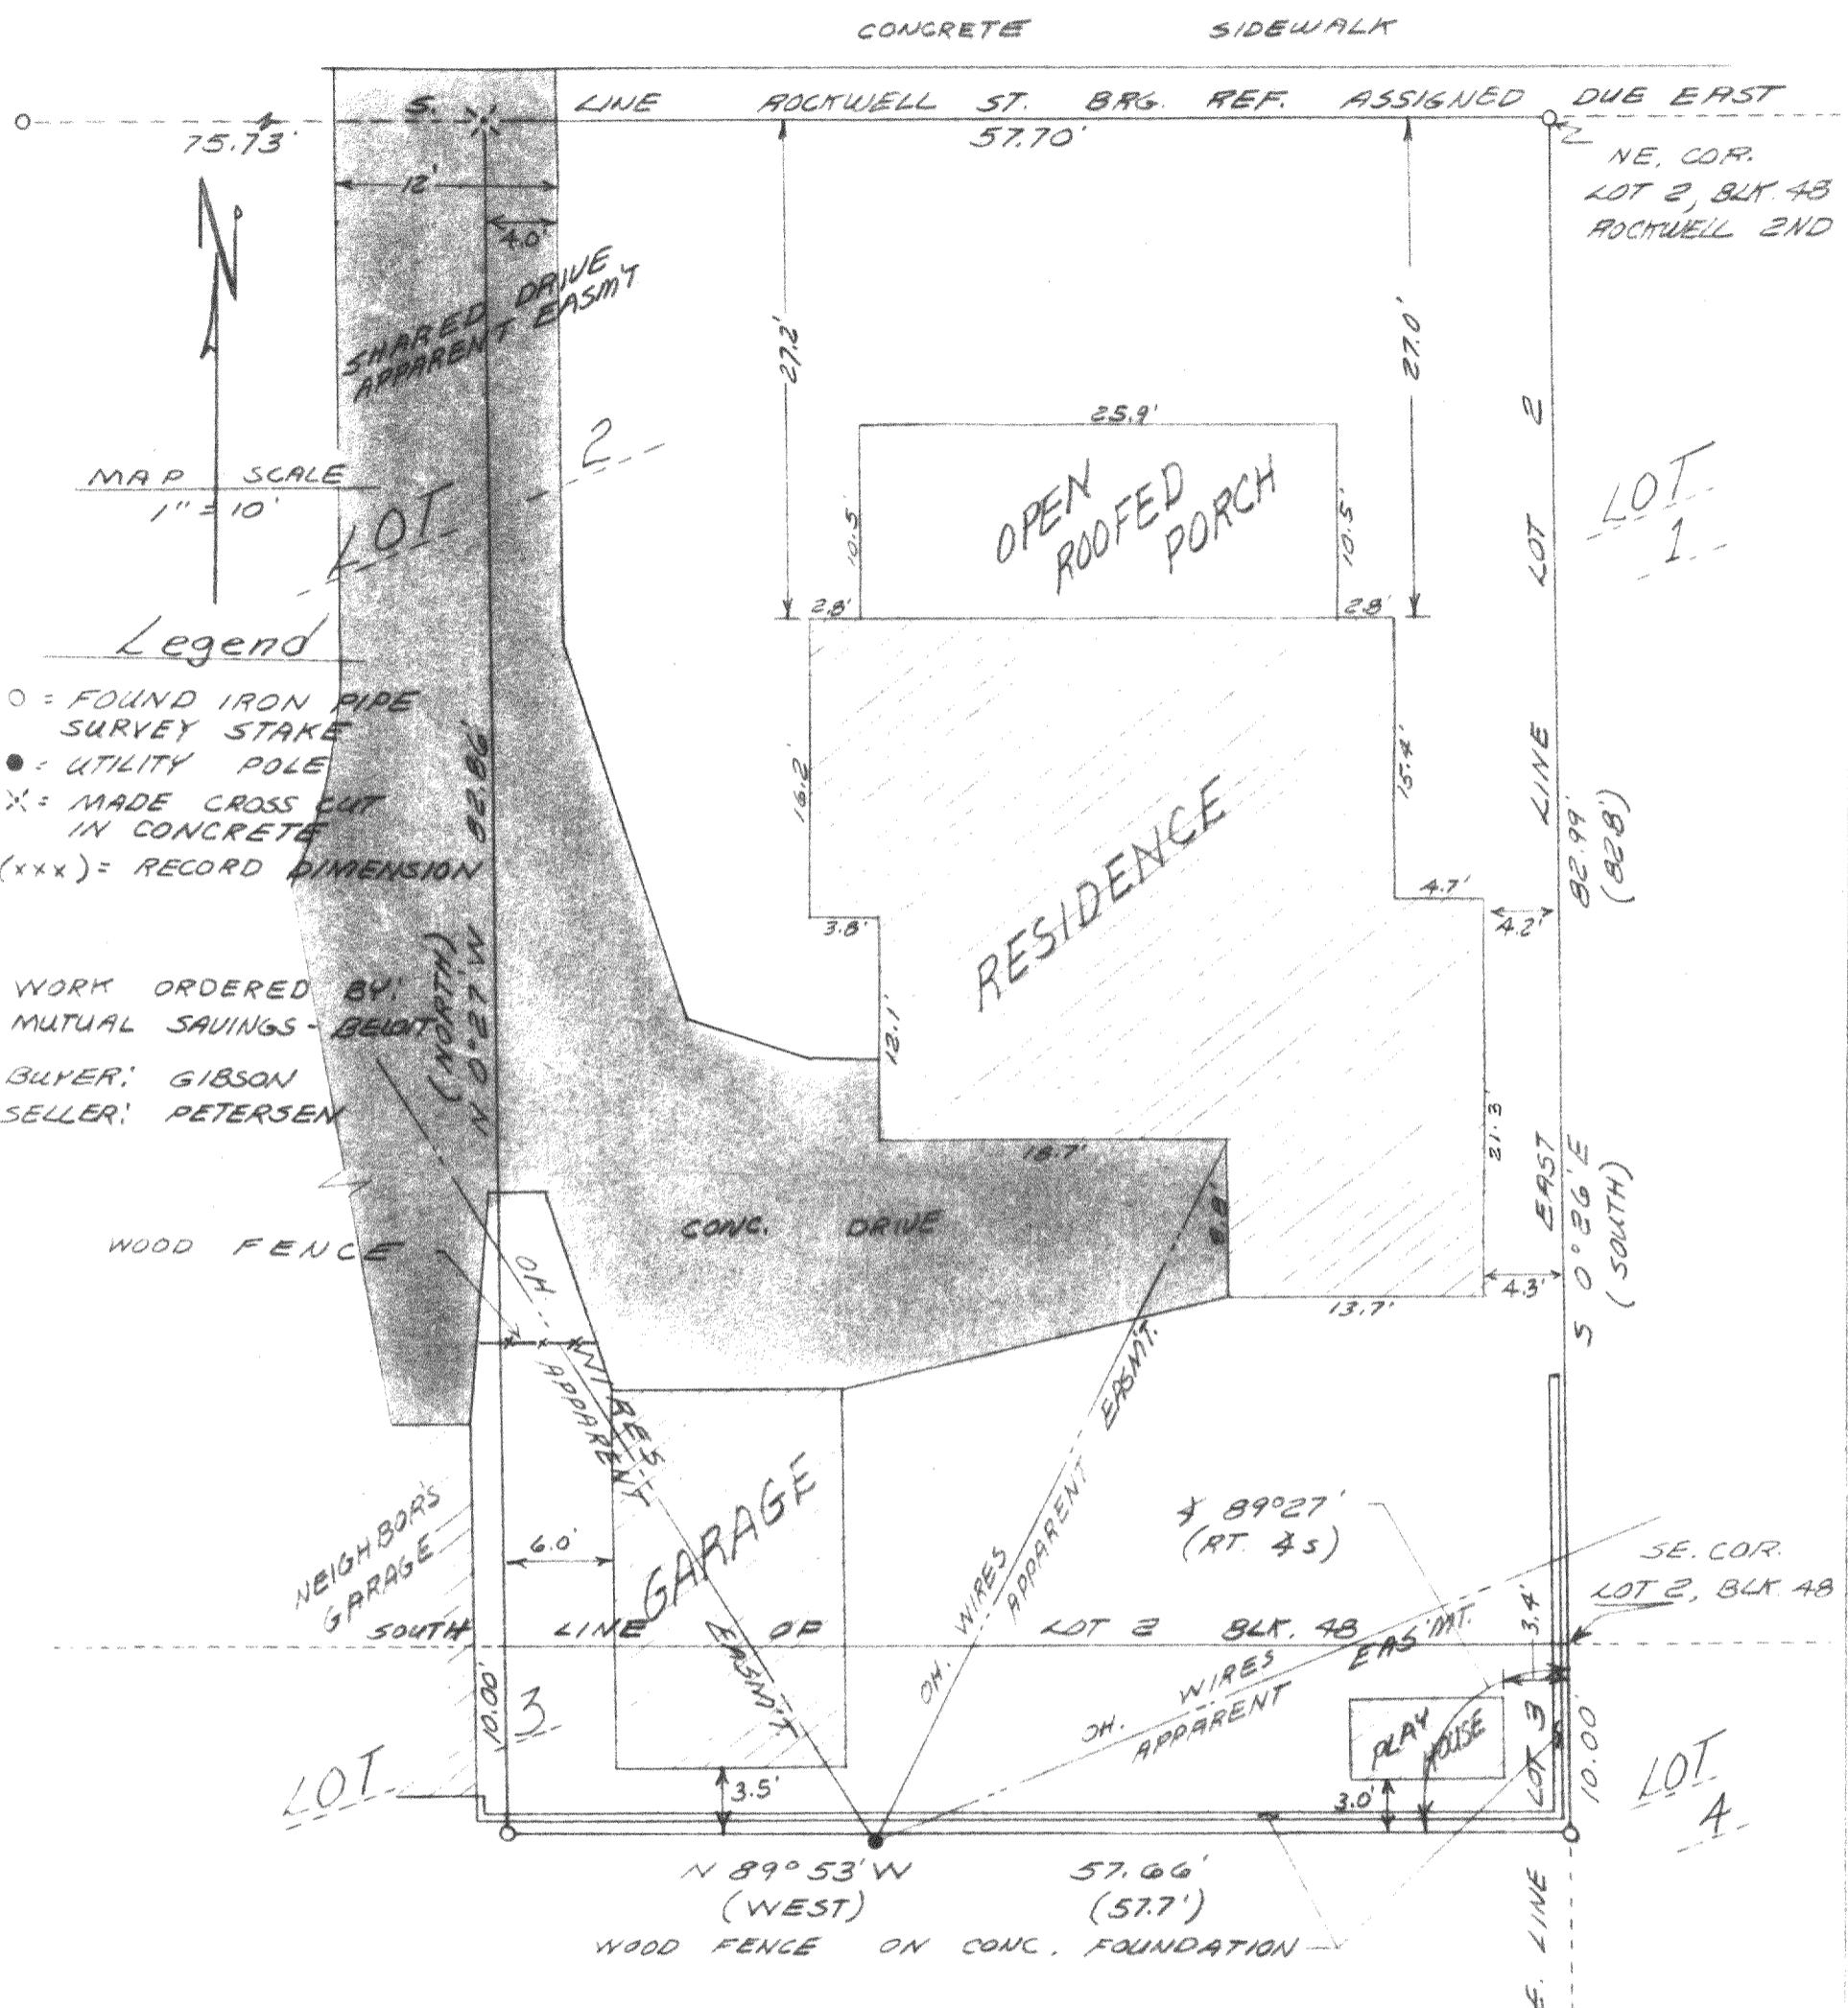

I hereby certify that I have surveyed the above described property and that the above map is a true representation thereof and shows the size and location of the property, its exterior boundaries, the location of all visible structures and dimensions of all principal buildings thereon, boundary fences, apparent easements, roadways and visible encroachments, if any.

This survey is made for the use of the present owners of the property, and also those who purchase, mortgage, or guarantee the title thereto within one (1) year from date hereof.

date hereof. 

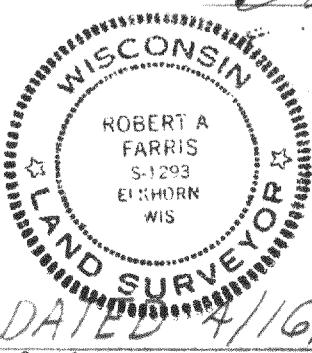

DATED 4/16/84

URW2-00007

FARRIS, HANSEN & ASSOCIATES, INC.
715 W. Walworth St. P.O. Box 487
Elkhorn, WI 53121

Schedule A – (Continued)

Legal Description Surveyed

Parcel 1: Beginning at an iron pin set at the NE corner of Lot 2, Block 46 of Becknell's Second Addition to the original plat of the Village, (now City) of Elkhorn; thence S. on the E. line of said lot 82.8 feet to an iron gas pipe set in the SE corner of said lot; thence W. on the S. line thereto 57.7 feet to an iron pin; thence N. 82.86 feet to a cross marked in the driveway, which point is in the W. line of said lot 2; thence S. on the N. line thereof 57.7 feet to the place of beginning.

Parcel 2: Commencing at the NW corner of Lot 3, Block 48 Beckwill's Second Addition to the original plat of the Village, (new City) of Elkhorn; thence S. in the E. line of said lot 16 feet to a point; thence W. at right angles to said E. line in a straight line 57.7 feet to a point; thence N. in a straight line parallel to the E. line of said Lot 3 to a point located in the N. line of said Lot 3; thence E. in said N. line of Lot 3, 57.7 feet to the place of beginning.

(Tax Reg. No. T-1002 0007)

PROJ. # 2233

4-347 ✓