


DESCRIPTION: Lot 2 of Block 2 of Fairlane Subdivision, located in the City of Elkhorn, Walworth County, Wisconsin.

CERTIFICATE: I, James F. Biagi, surveyor do hereby certify that I have surveyed the property hereon described and that the location of the proposed improvements are as shown.

July 29, 1963

James F. Biagi RLS 272

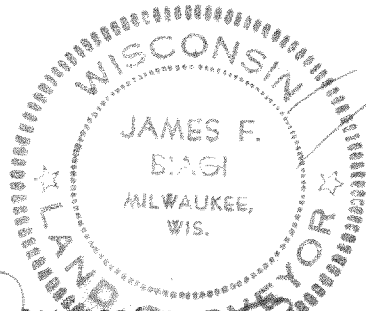

Recertification:

July 14th 1964

James F. Biagi RLS 272  
Elkhorn, Wisconsin.