

## ABELL SURVEYING & MAPPING DELAVAN, WISCONSIN 53115 414-728-6737

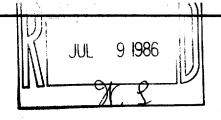

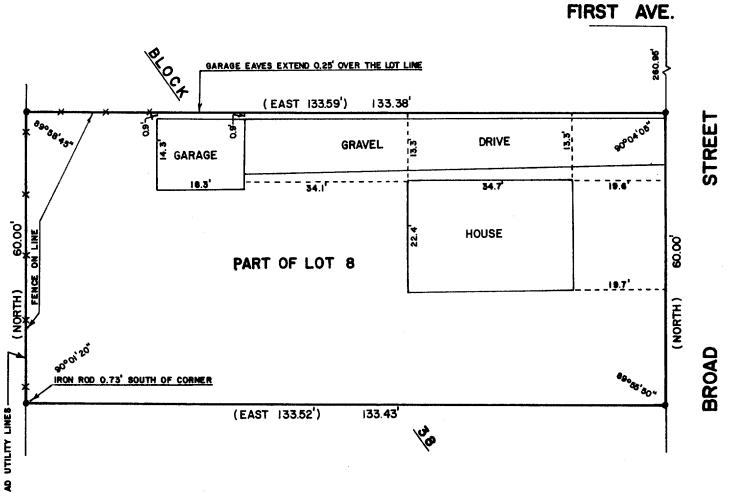

## PLAT OF SURVEY OF

PART OF LOT 8, BLOCK 38, DAVIS ADDITION, CITY OF ELKHORN, WALWORTH COUNTY, WISCONSIN AS DESCRIBED IN VOLUME 358 OF RECORDS ON PAGE 463 AS DOCUMENT NO. 123328, WALWORTH COUNTY, WISCONSIN.

DAVID F.

ABELL

S. 1596
Delayan,
Wis.

NOTE: MR. TUBBS,
ELKHORN AND
IN THE BLOC
IN THE CITY

I HEREBY CERTINABOVE DESCRIBE
MAP IS A TRUE



SCALE

MR. TUBBS, AS CITY ENGINEER, RESURVEYED ELKHORN AND FOUND OVERRUN AND UNDERRUN IN THE BLOCKS AND RECORDED THE MEASUREMENTS IN THE CITY ENGINEERING RECORDS.

I HEREBY CERTIFY THAT I HAVE SURVEYED THE ABOVE DESCRIBED PROPERTY AND THAT THE ABOVE MAP IS A TRUE REPRESENTATION THEREOF AND SHOWS THE SIZE AND LOCATION OF THE PROPERTY, ITS EXTERIOR BOUNDARIES, THE LOCATION OF ALL PRINCIPAL BUILDINGS THEREON, BOUNDARY FENCES, APPARENT EASEMENTS, ROADWAYS, AND VISIBLE ENCROACHMENTS, IF ANY, TO THE BEST OF MY KNOWLEDGE AND BELIEF.

THIS SURVEY IS MADE FOR THE USE OF THE PRESENT OWNERS OF THE PROPERTY, AND ALSO THOSE WHO PURCHASE, MORTGAGE, OR GUARANTEE THE TITLE THERETO WITH ONE (1) YEAR FROM DATE HEREOF.

LEGEND

1"=20'

- 1" IRON ROD FOUND - RECORDED AS

WISCONSIN REGISTERED LAND SURVEYOR, S-1596

/986 JOB NUMBER - 86014