


33.0'

239 West Page St.

01
23

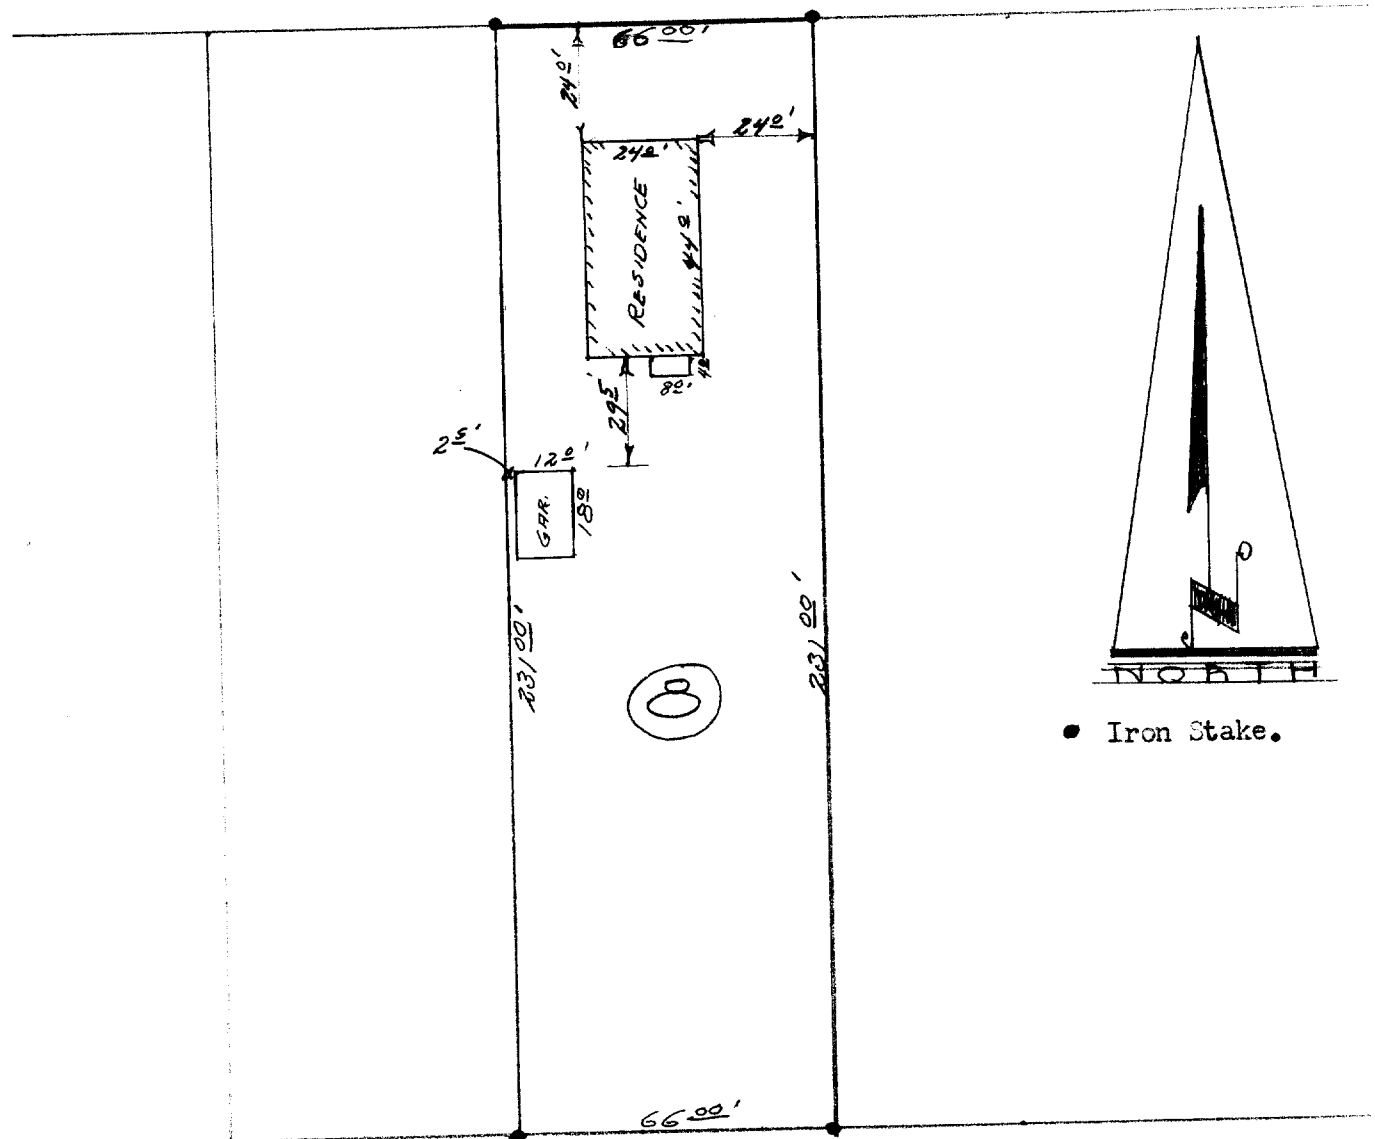


• Iron Stake.

DESCRIPTION:

Lot 8 Fairview Addition, City of Elkhorn, Walworth County, Wisconsin.

CERTIFICATE: I, hereby certify that I have surveyed the above mentioned property and that the above plat is an accurate survey and a true representation thereof and correctly shows the exterior boundary lines and location of buildings and other improvements on said property and the correct measurements thereof.

Dated: August 26th 1965.

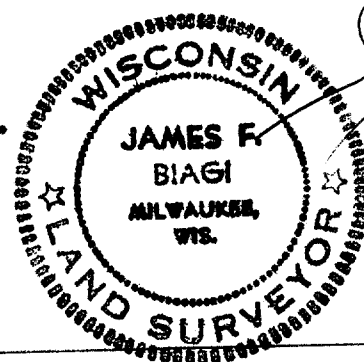

James F. Biagi. RLS/272
Elkhorn, Wisconsin.

YFR-8

4-40B