


59-38
4-46B

WEST GENEVA ST.

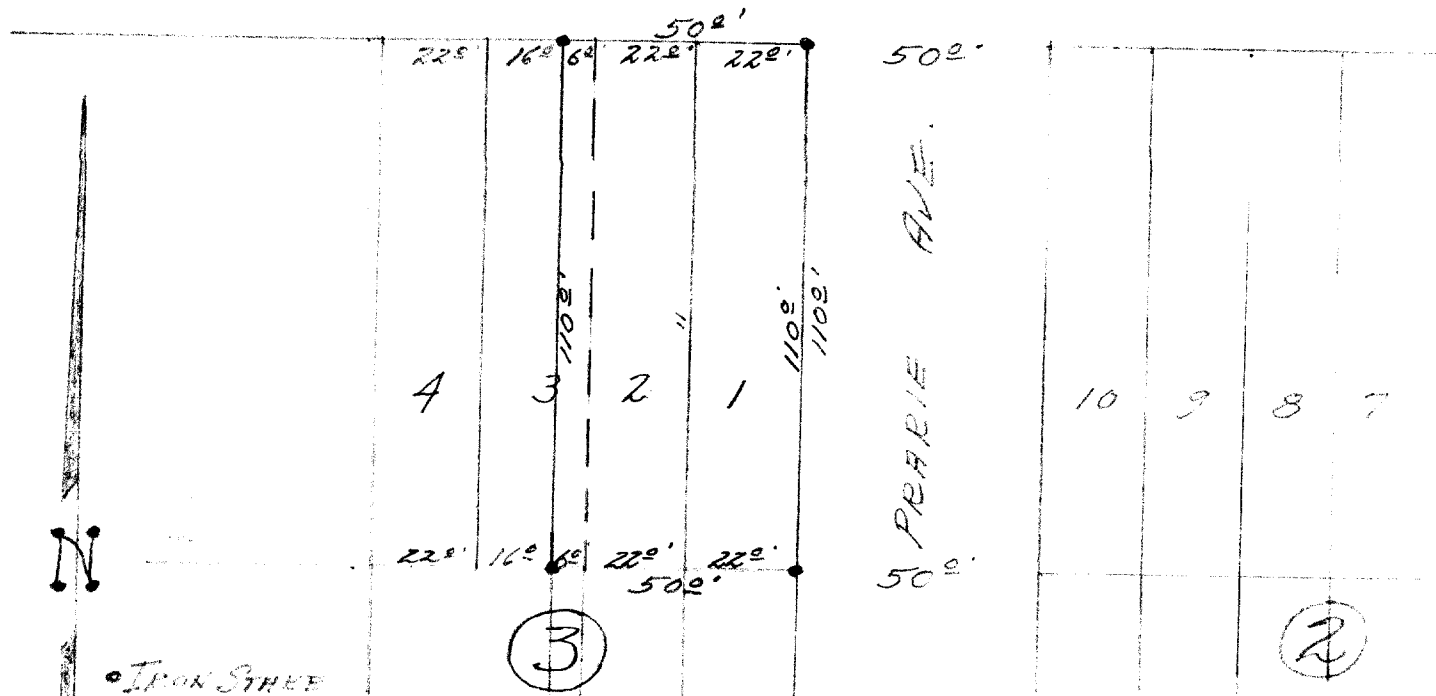

DESCRIPTION:

Lots 1, 2, and the East 6 feet of Lot 3, Block 3, Elkhorn Gardens Subdivision of a portion of the City of Elkhorn, Walworth County, Wisconsin.

CERTIFICATE:

I, hereby certify that I have on this the 12th day of August, 1959, surveyed the above described property according to the recorded plat and find that no encroachments exist.

SIGNED AND SEALED ON THIS THE 15TH DAY OF AUGUST 1959.

~~James F. Biagi~~

James F. Biagi.
Registered Surveyor.
Elkhorn Wisconsin.

VEN-17

4-46B