
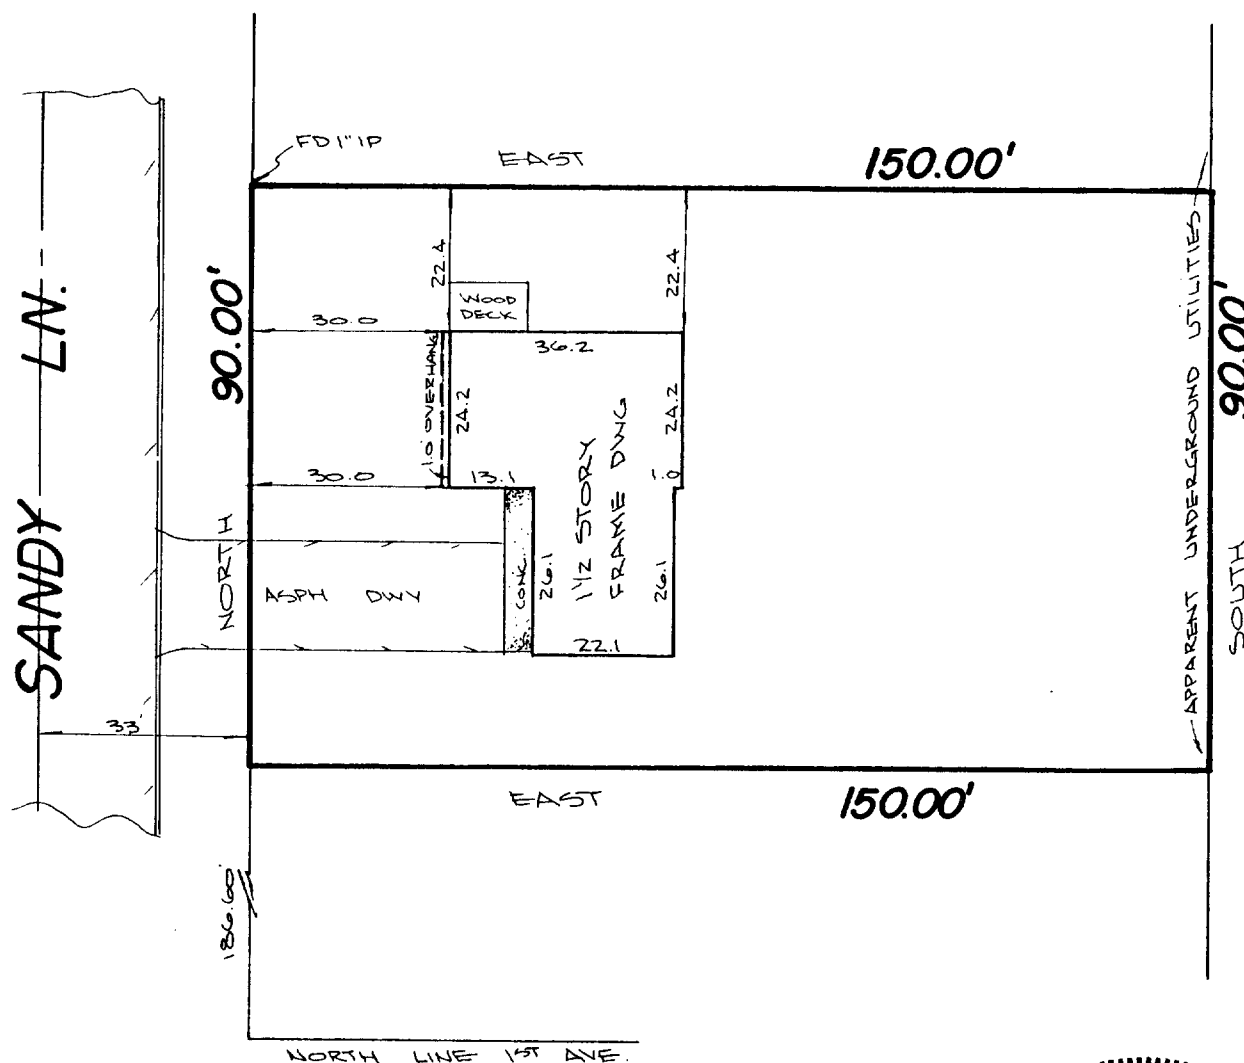


Plat of Survey

FOR: MID-STATES MORTGAGE - RAYMOND & HARRIETTE SABIN
PROPERTY ADDRESS: 411 Sandy Lane; Elkhorn, Wisconsin 53121

DESCRIPTION: Lot 3, Block 5, FAIRLANE SUBDIVISION ADDITION NO. 1, being a Subdivision of a part of the Southwest 1/4 of the Northwest 1/4 of Section 31, Township 3 North, Range 17 East, in the City of Elkhorn, Walworth County, Wisconsin.

NOTE: PROPERTY DOES NOT LIE WITHIN THE 100 YEAR FLOOD PLAIN PER F.E.M.A. FLOOD INSURANCE STUDY MAPS.

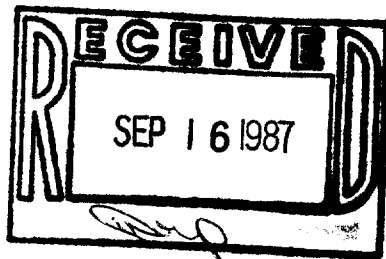

CERTIFICATE

STATE OF WISCONSIN)
WAUKESHA COUNTY) SS

I CERTIFY THAT I HAVE SURVEYED THE ABOVE DESCRIBED PROPERTY, AND THE ABOVE MAP IS A TRUE REPRESENTATION THEREOF AND SHOWS THE SIZE AND LOCATION OF THE PROPERTY, ITS EXTERIOR BOUNDARIES, THE LOCATION AND DIMENSIONS OF ALL STRUCTURES THEREON, FENCES, APPARENT EASEMENTS AND ROADWAYS AND VISIBLE ENCROACHMENTS, IF ANY.

THIS SURVEY IS MADE FOR THE EXCLUSIVE USE OF THE PRESENT OWNERS OF THE PROPERTY, AND ALSO THOSE WHO PURCHASE, MORTGAGE, OR GUARANTEE THE TITLE THERETO, WITHIN ONE (1) YEAR FROM DATE HEREOF.

THIS SURVEY IS COPYRIGHTED AND THE REPRODUCTION THEREOF, IS PROHIBITED.

MONUMENTATION OF MISSING BOUNDARY CORNERS HAS (NOT) BEEN WAIVED BY THE ABOVE CLIENT AS PER CHAPTER A-E.5.01(b) OF THE WISCONSIN ADMINISTRATIVE CODE.

REGISTERED LAND SURVEYOR

DATE

TERRA TECHNOLOGY, Inc.

Land Surveyors - Land Planners



909 Blackstone Avenue

Waukesha, WI 53186

(414) 549-1111

JOB NUMBER: 4717

SCALE: 1" = 30'

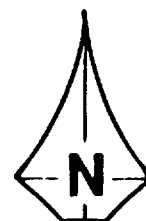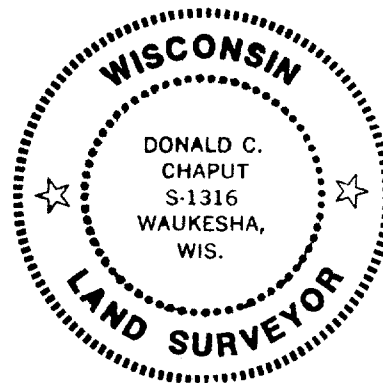

YFLA-21

4-479