

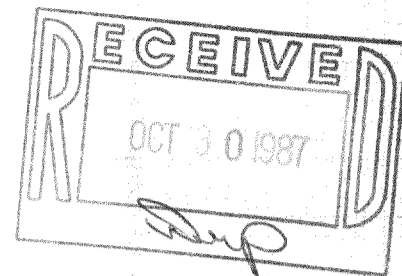


Plat of Survey of Lot 12 Mann Bros. Addition to the City of Elkhorn,
Walworth County, Wisconsin.

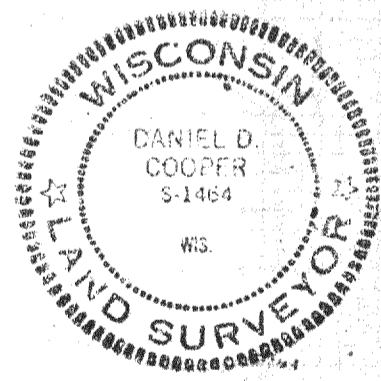

D. D. COOPER & CO., INC.
Daniel D. Cooper
Rt. 4 Box 508B
Elkhorn, WI 53121

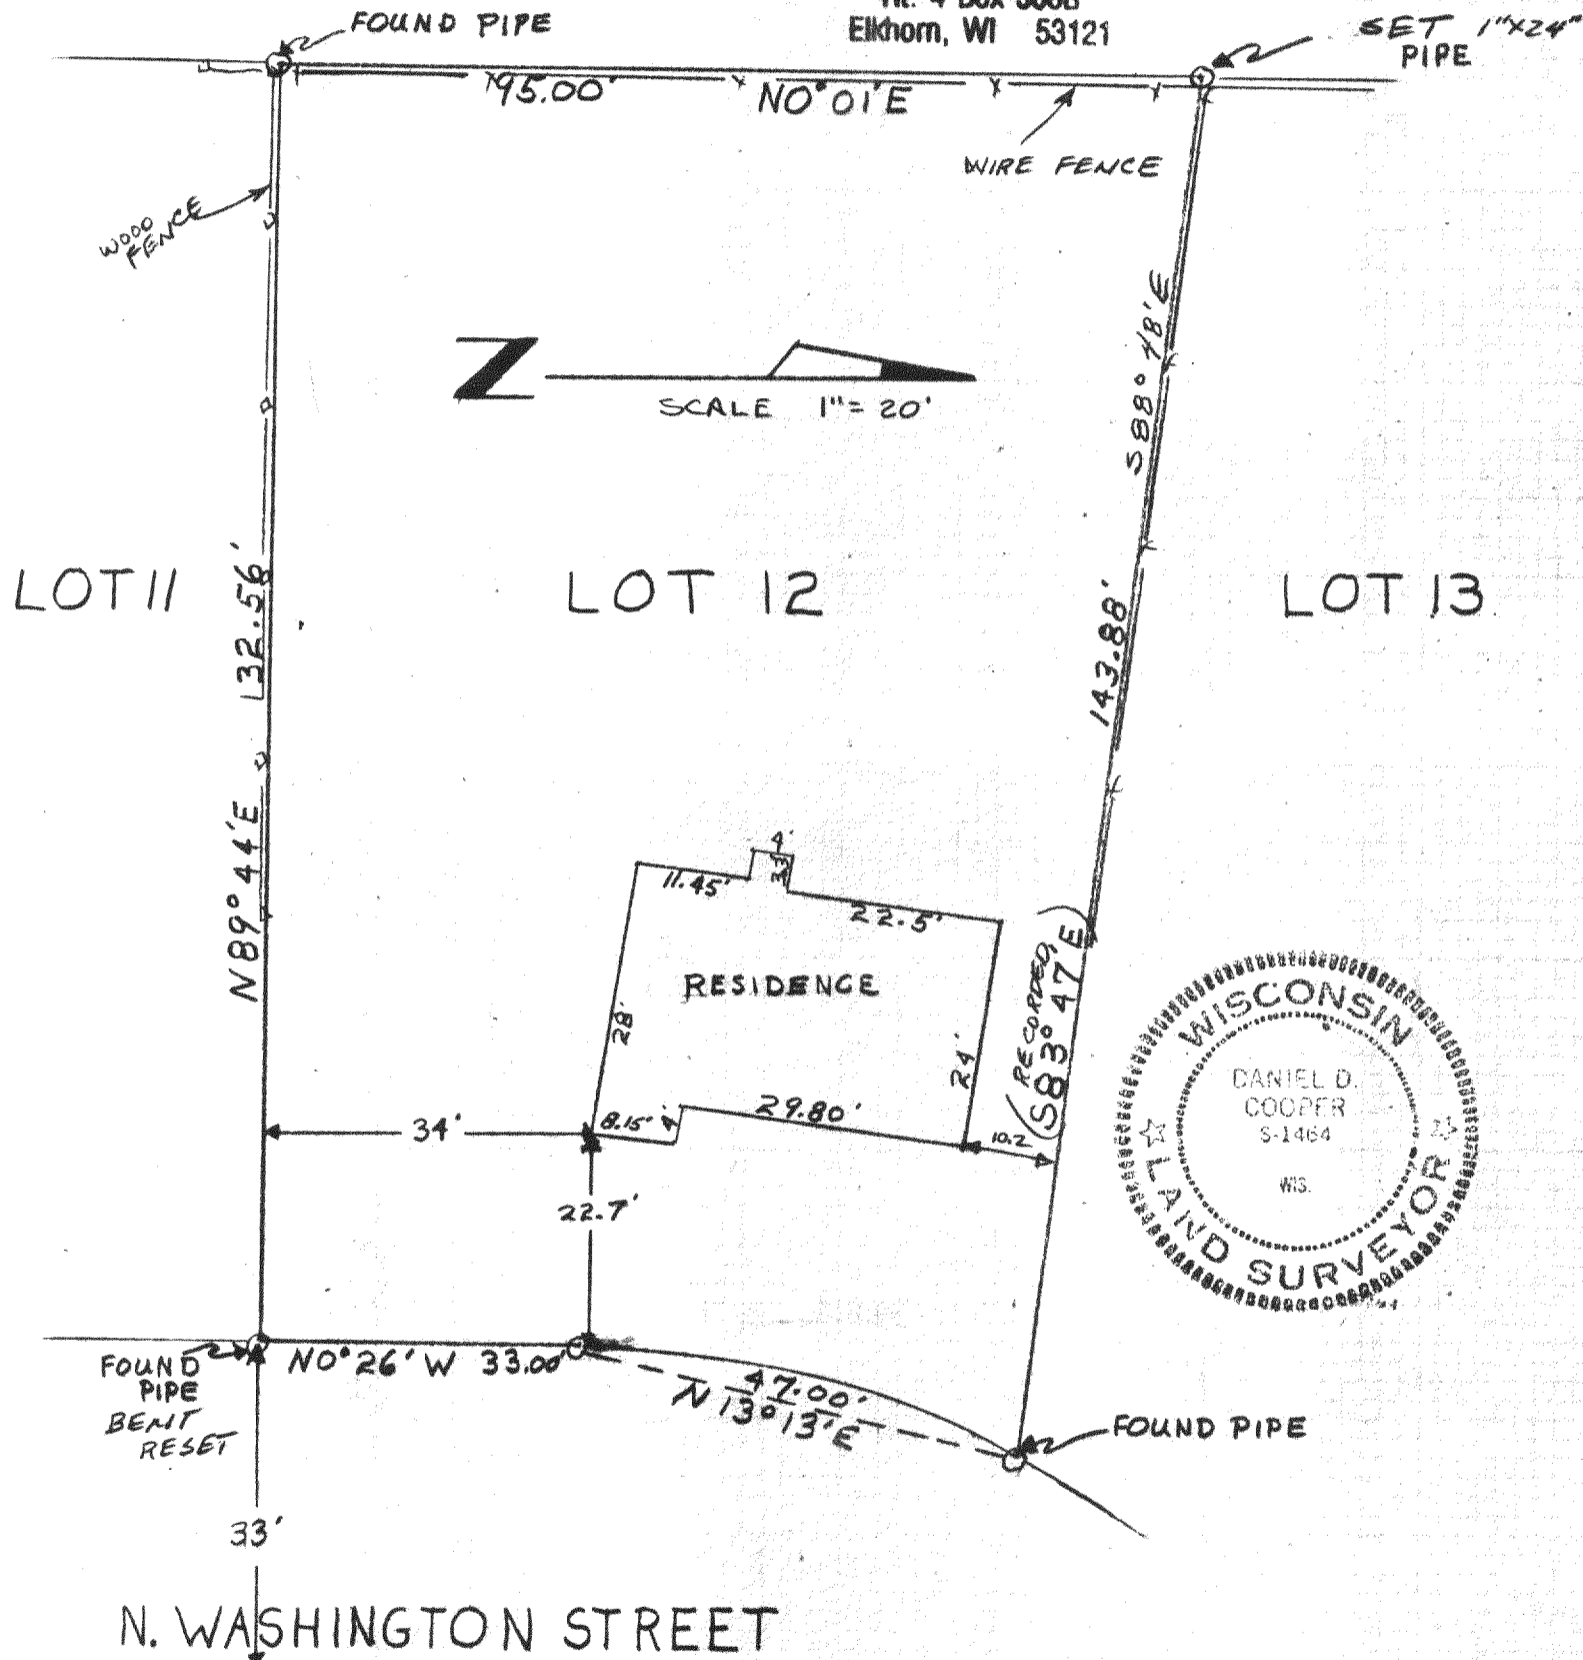

I hereby certify that I have surveyed the property described hereon and that the above map is a true and accurate representation thereof to the best of my professional knowledge and belief.

Dated this 13 day of Aug., 1987

Daniel D. Cooper
Daniel D. Cooper, RLS No. S-1464

Drawing No. 3129-S