

D.D. COOPER & CO. INC.


Route 4 Box 508B
Elkhorn WI 53121
Phone-414-723-6265

B.M.
TOP OF IRON
ASSUMED ELE. 100.0

PLAT OF SURVEY OF LOT 7 BLOCK 1 OF
JAMES JONES 2ND ADDITION TO THE CITY
OF ELKHORN WALWORTH COUNTY WISCONSIN

SURVEY ORDERED BY
ATTY RANDAL LEECE

BEARING REFERENCE
NORTHERLY LINE OF WESTWARD DRIVE ASSUMED
TO BEAR N89° 22' E AS PREVIOUSLY PLTTD

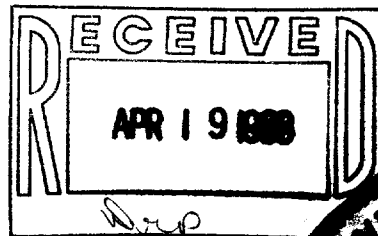

I, DANIEL D. COOPER, REGISTERED SURVEYOR, DO HEREBY CERTIFY THAT
I HAVE SURVEYED THE PROPERTY DESCRIBED HEREON AND THAT THE MAP
SHOWN HEREON IS A TRUE AND ACCURATE REPRESENTATION THEREOF TO THE
BEST OF MY PROFESSIONAL KNOWLEDGE AND BELIEF.

DATED THE 22ND DAY OF MAY, 1986

Daniel D. Cooper
DANIEL D. COOPER, RLS NO. 9-1464

SCALE 1" = 30'

REVISED. Aug. 5TH TO SHOW EXISTING RESIDENCE.

REVISED - ADDED ELEVATIONS June 3, 1986 D.C.

DRAWING NO. 2201-4-48

4-498

