


D. D. COOPER & CO., INC.
 Daniel D. Cooper
 Rt. 4 Box 5088
 Elkhorn, WI 53121

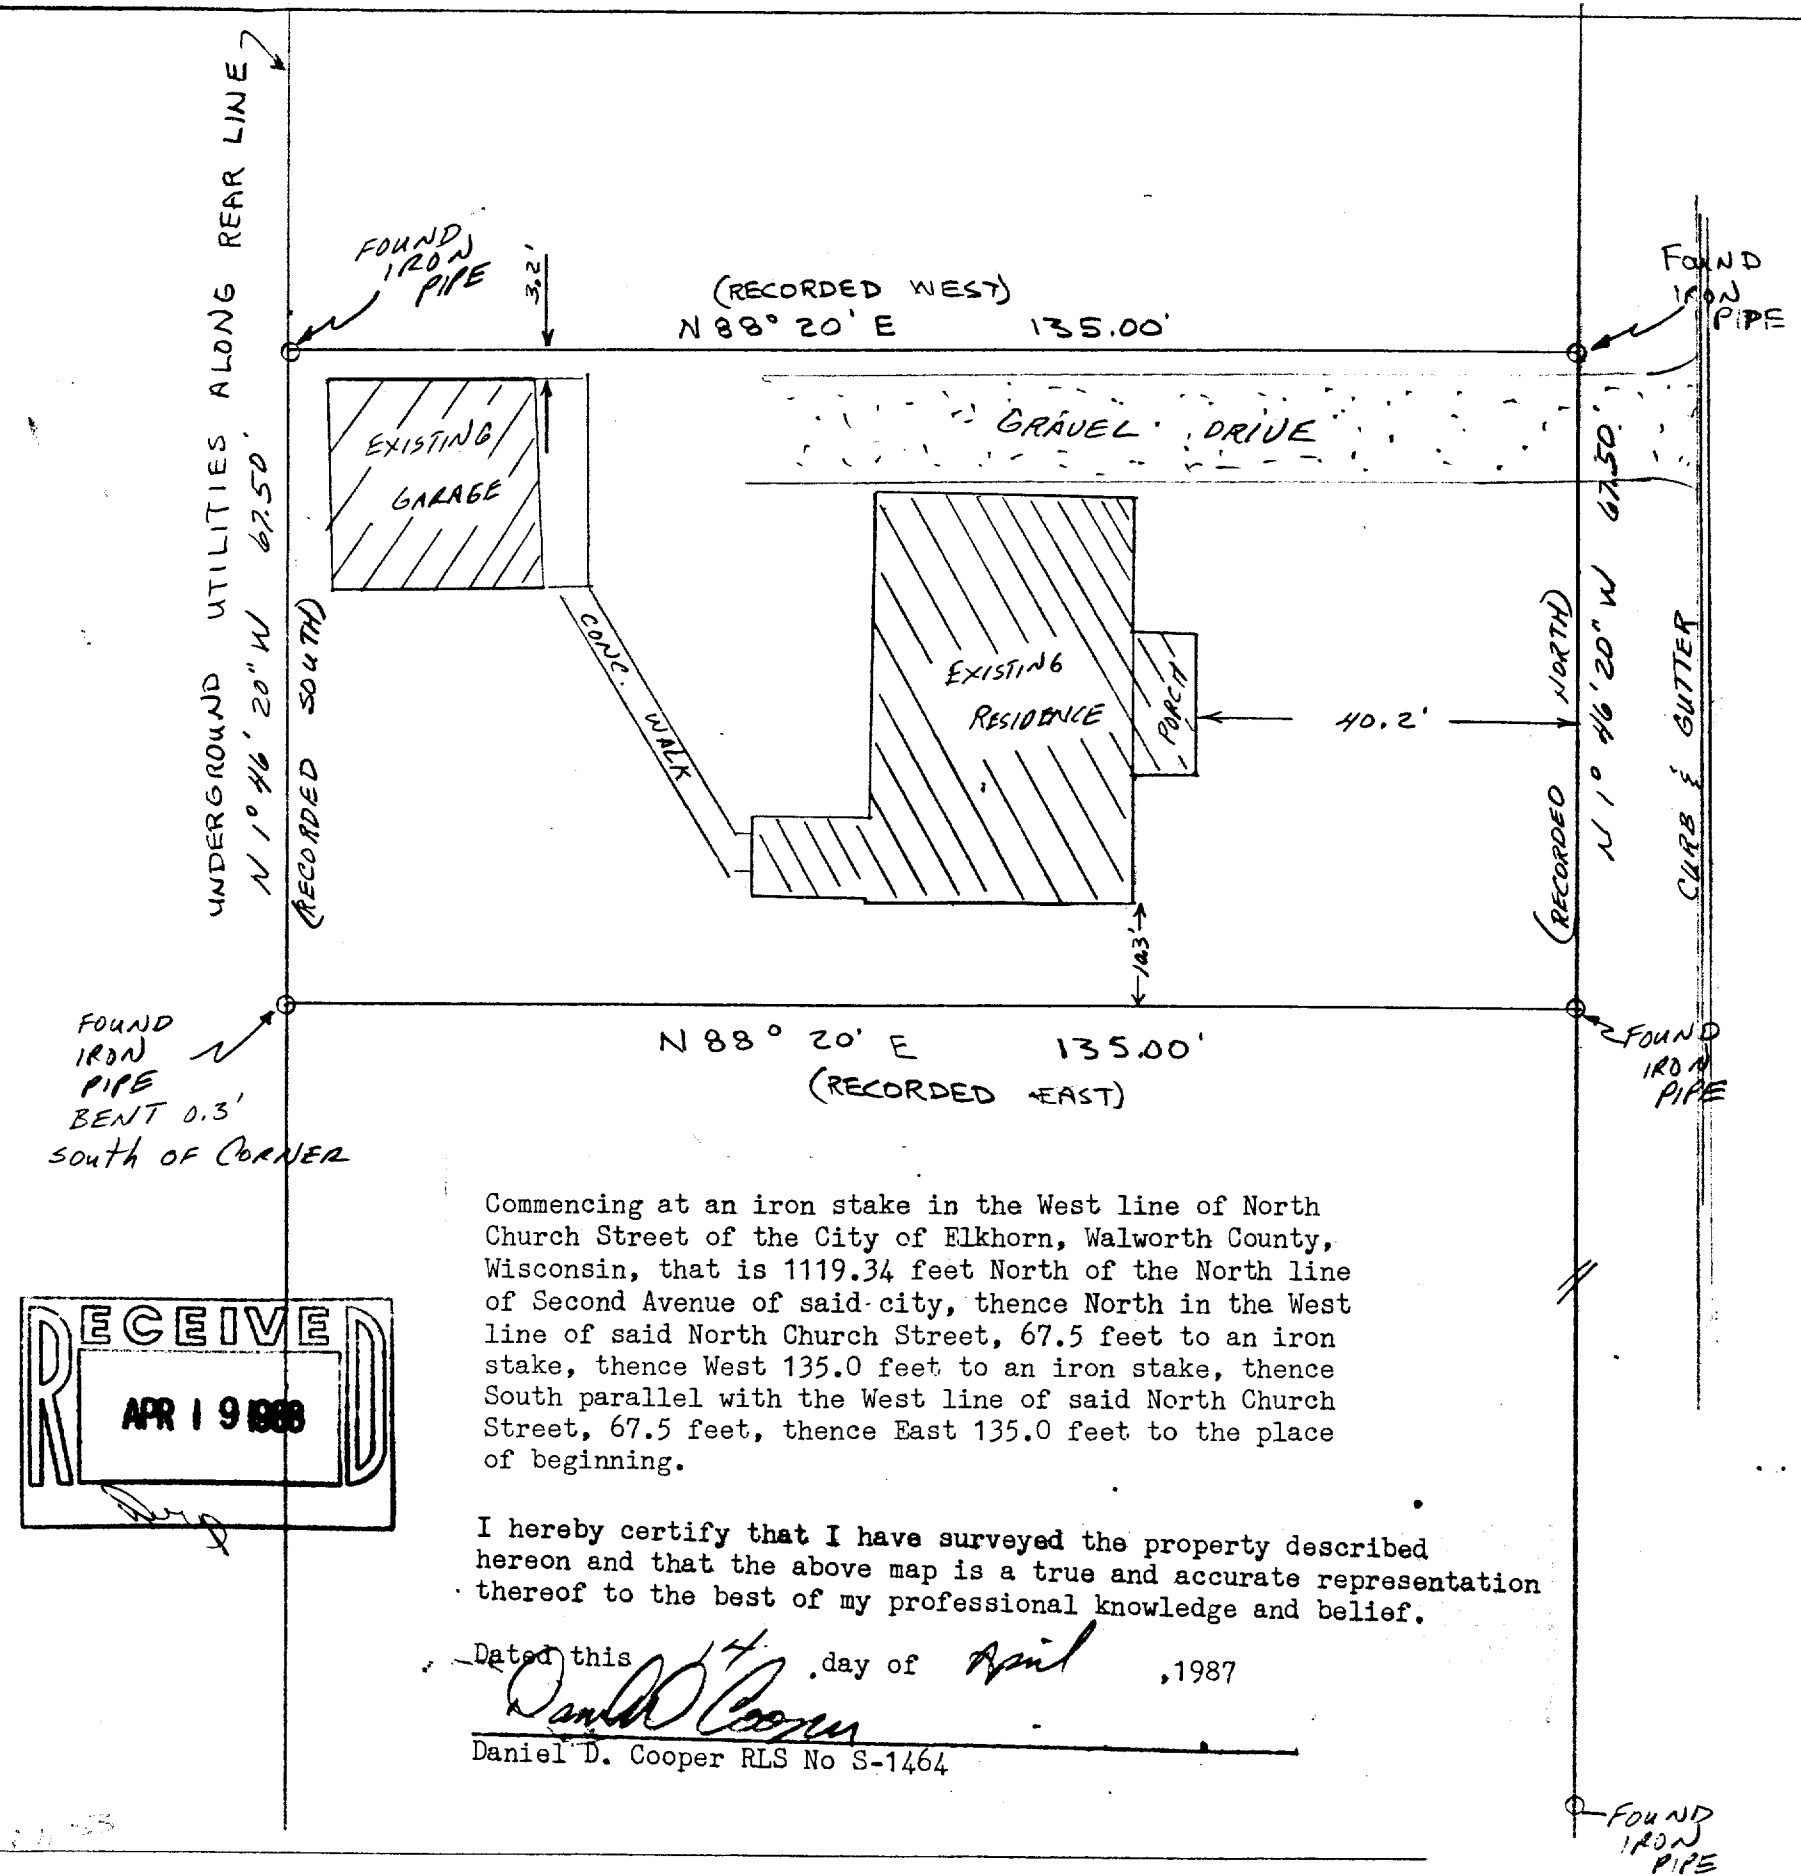

RECEIVED
 APR 19 1988

Commencing at an iron stake in the West line of North Church Street of the City of Elkhorn, Walworth County, Wisconsin, that is 1119.34 feet North of the North line of Second Avenue of said city, thence North in the West line of said North Church Street, 67.5 feet to an iron stake, thence West 135.0 feet to an iron stake, thence South parallel with the West line of said North Church Street, 67.5 feet, thence East 135.0 feet to the place of beginning.


I hereby certify that I have surveyed the property described hereon and that the above map is a true and accurate representation thereof to the best of my professional knowledge and belief.

Dated this 4 day of April, 1987
 Daniel D. Cooper
 Daniel D. Cooper RLS No S-1464

NORTH CHURCH STREET

SCALE 1"=20'

SURVEYED FOR
 MODERN REALTY
 ELKHORN WI.

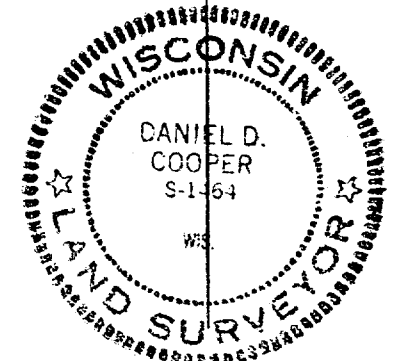

DRAWING NO. 3083-6-59

4-525