

FARRIS, HANSEN & ASSOCIATES, INC.

7 RIDGEWAY COURT, P.O. BOX 487, ELKHORN, WISCONSIN

TEL. 414-723-2098



LOCATION: SOUTHWEST CORNER OF SOUTHEAST 1/4 OF
SEC 36 - 3 - 16 CITY OF ELKHORN, WALWORTH
COUNTY, WIS.

WORK ORDERED BY: WESLEY ERSKINE


MAP LEGEND

- O = IRON PIPE STAKE FOUND
- = IRON PIPE STAKE SET
- = IRON ROD STAKE FOUND
- = IRON ROD STAKE SET
- = CONCRETE MONUMENT FOUND
- (XXXXX) = RECORD DIMENSION

MAP SCALE IN FEET

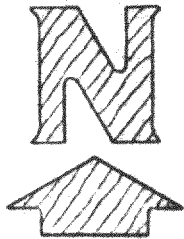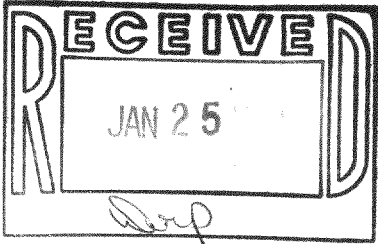

TAX CODE # RM-21

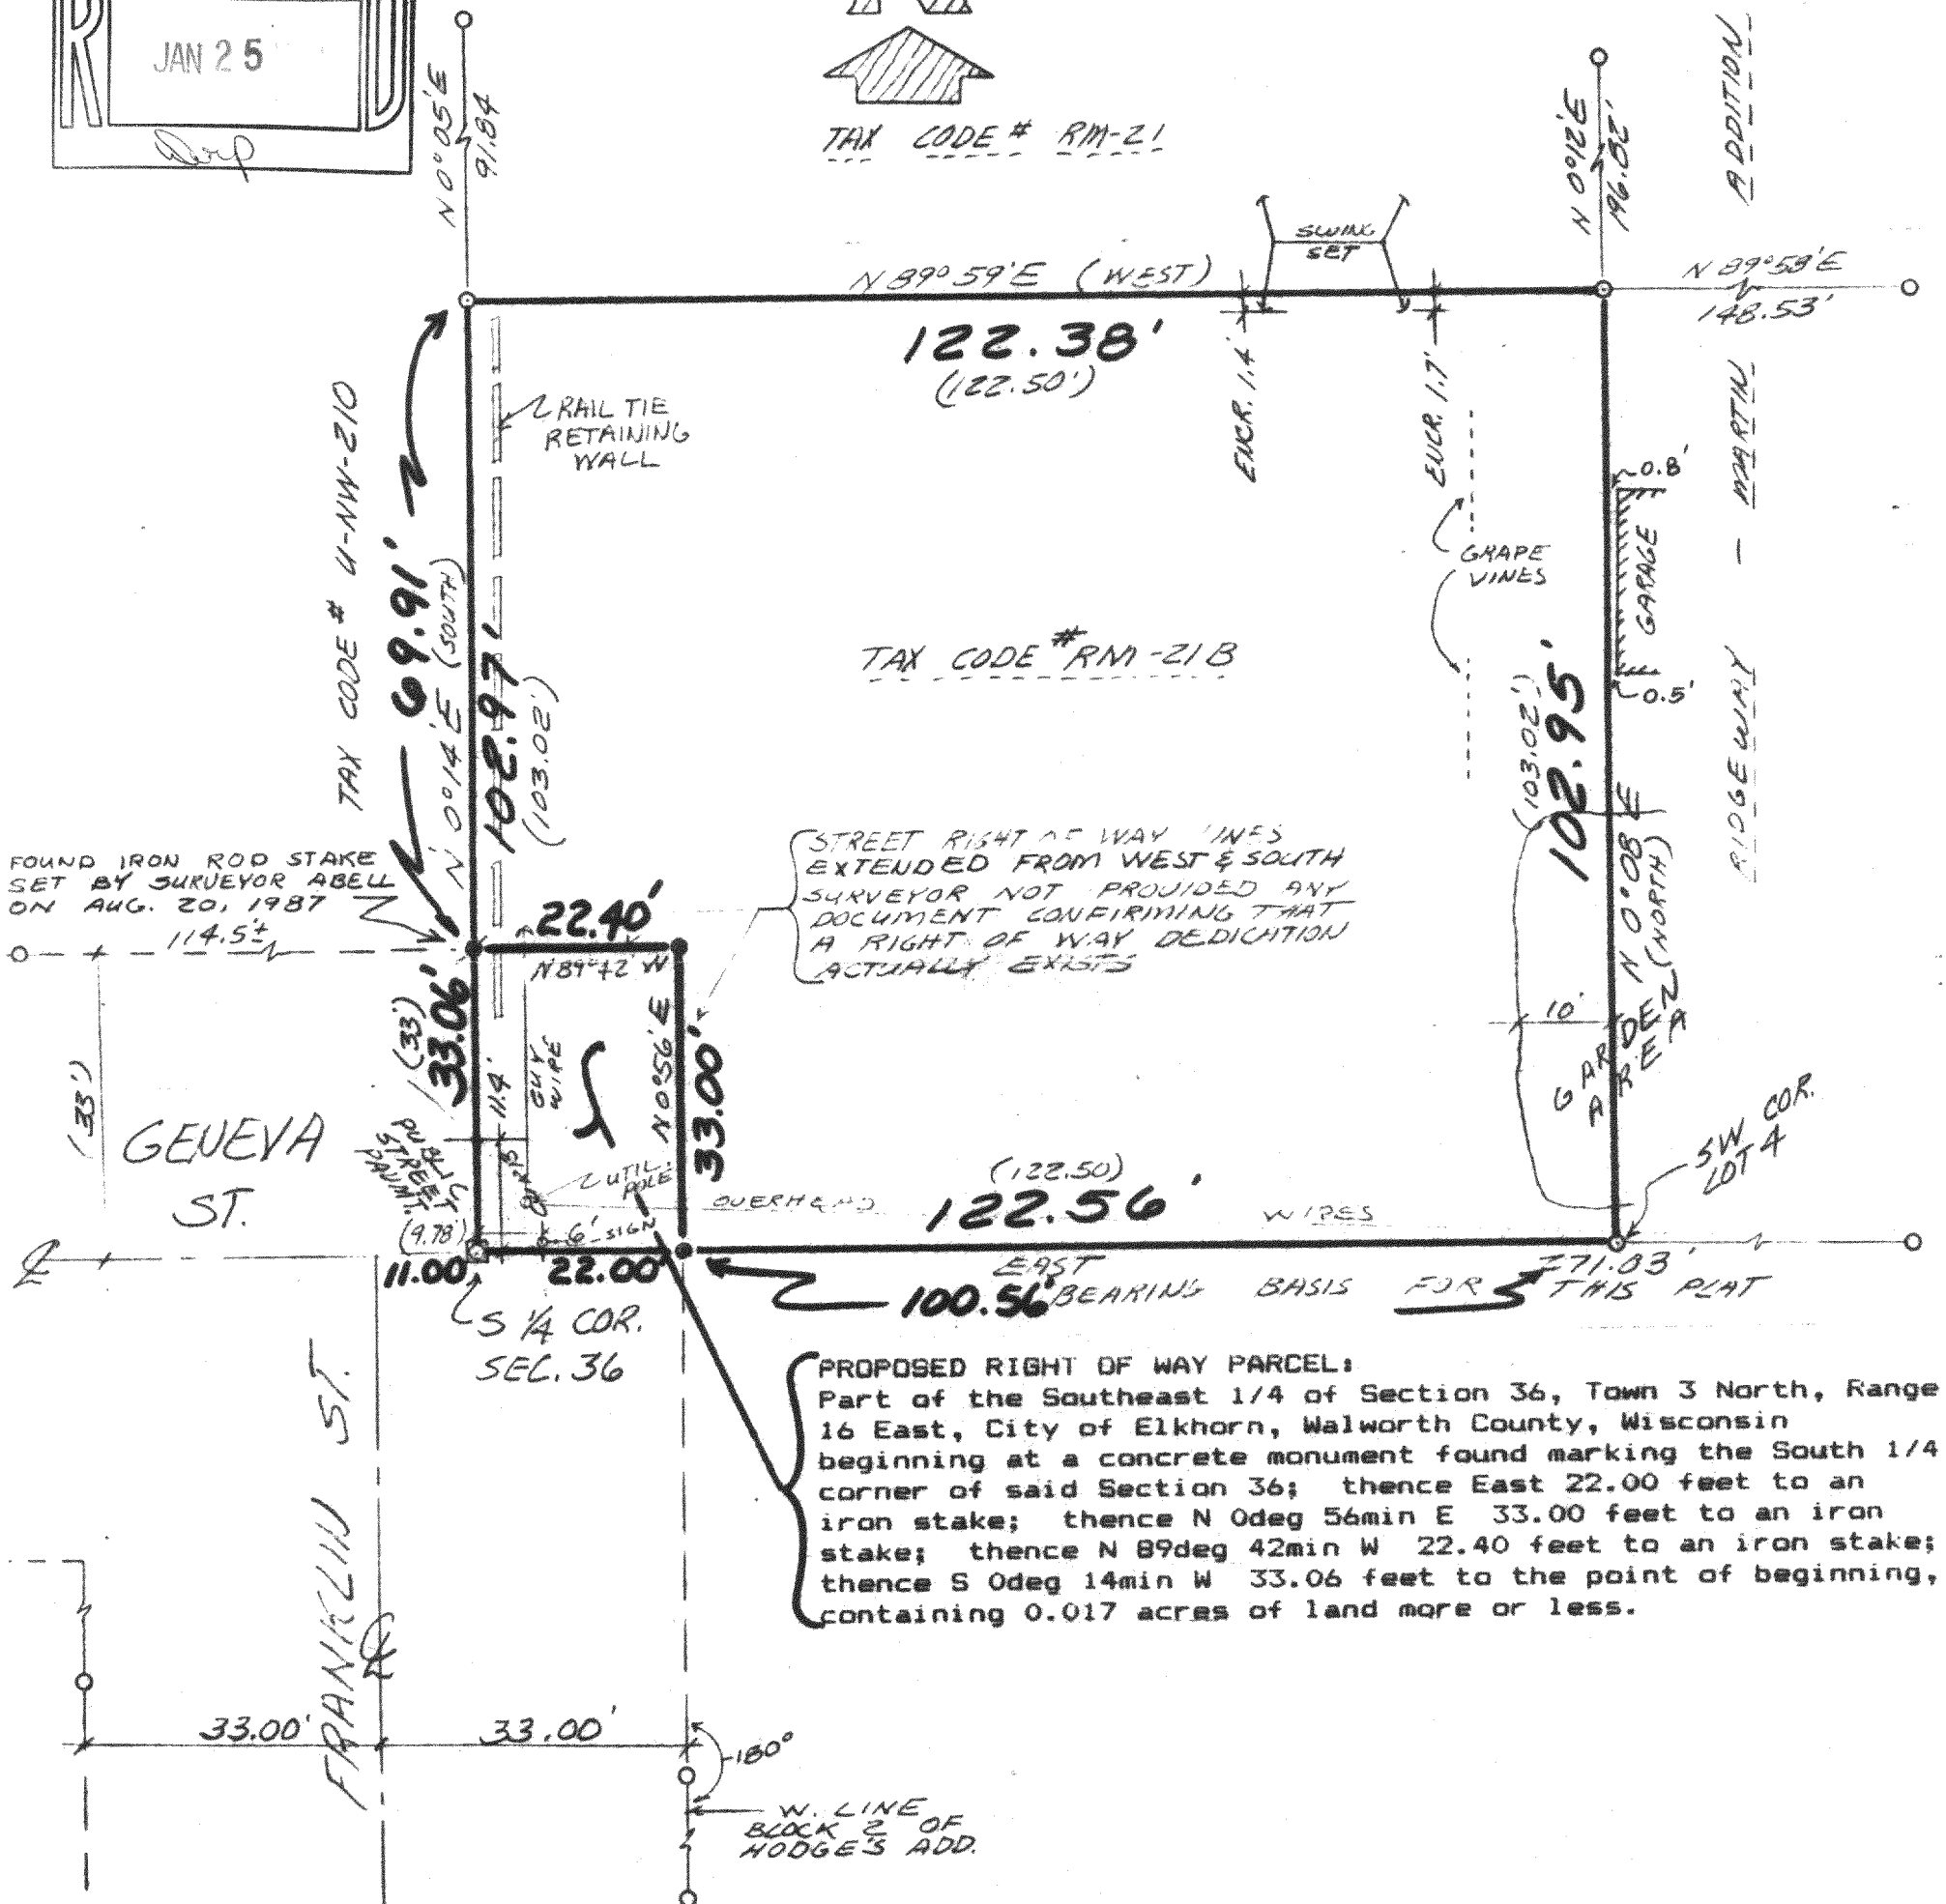

IMPORTANT NOTE: The surveyor has done no title research other than examination of the legal description provided and copied on sheet 2. User of this plat should ascertain that no other documents affect title to this property.

I hereby certify that the above described property has been surveyed under my direction and that the above map is a true representation thereof and shows the size and location of the property, its exterior boundaries, the location of all visible structures and dimensions of all principal buildings thereon, boundary fences, apparent easements, roadways and visible encroachments, if any. This survey is made for the use of the present owners of the property, and also those who purchase, mortgage, or guarantee the title thereto within one year from the date hereof.

DATED: AUG 5, 1987

REVISED NOV. 16, 1987 TO SHOW ROW EXTENSIONS REQUESTED BY CITY

PROJ. NO. 2864
SHEET 1 OF 2 SHEETS

YRM-21B

4-510

FARRIS, HANSEN & ASSOCIATES, INC.

7 RIDGEWAY COURT, P.O. BOX 487, ELKHORN, WISCONSIN

TEL. 414-723-2098

LOCATION: SOUTHWEST CORNER OF SOUTHEAST 1/4 OF
SEC 36 - 3 - 16 CITY OF ELKHORN, WALWORTH
COUNTY, WIS.

WORK ORDERED BY: WESLEY ERSKINE

35827

VOL. 215 PAGE 523

STATE OF WISCONSIN—FORM 2
THIS SPACE RESERVED FOR RECORDING DATA

THIS INDENTURE, Made this 18th day of July
A. D., 1978, between State Bank of Elkhorn

_____ a Corporation
duly organized and existing under and by virtue of the laws of the State of Wisconsin, located
at Elkhorn Wisconsin, party of the first part and
Wesley Erskine

part Y of the second part,

Witnesseth, That the said party of the first part, for and in consideration
of the sum of Eight Thousand and no/100 (\$8,000.00) Dollars

_____ to it paid by the said party _____ of the second part, the receipt whereof is hereby
confessed and acknowledged, has given, granted, bargained, sold, remised, released, aliened, conveyed and confirmed, and by these presents
does give, grant, bargain, sell, remise, release, alien, convey and confirm unto the said party _____ of the second part, his heirs and assigns
forever, the following described real estate situated in the County of Walworth and State of Wisconsin, to-wit:

A parcel of land located in the Southeast 1/4 of Section 36, T3N, R16E,
Walworth County, Wisconsin described as follows, to-wit: Beginning
at the South 1/4 corner of Section 36; thence East along the South line
of said Section 36, 122.50 feet to the Southwest corner of Lot 4, Block
3 of Ridgeway-Martin Addition to the City of Elkhorn; thence North
along the West line of the said Ridgeway-Martin Addition 103.02 feet;
thence West parallel to the South line of said Section 36, 122.50 feet
to the North-South 1/4 line of Section 36; thence South along the North-
South 1/4 line 103.02 feet to the place of beginning.

(IF NECESSARY, CONTINUE DESCRIPTION ON REVERSE SIDE)

Together with all and singular the hereditaments and appurtenances thereunto belonging or in any wise appertaining; and all the estate
right, title, interest, claim or demand whatsoever, of the said party of the first part, either in law or equity, either in possession or expectancy
of, in and to the above bargained premises, and their hereditaments and appurtenances.

To Have and To Hold the said premises as above described with the hereditaments and appurtenances, unto the said party _____ of the
second part, and to his heirs and assigns FOREVER.

And the said State Bank of Elkhorn

party of the first part, for itself and its successors, does covenant, grant, bargain and agree to and with the said party _____ of the
second part, his heirs and assigns, that at the time of the enrolling and delivery of these presents it is well seized of the
premises above described, as of a good, sure, perfect, absolute and indefeasible estate of inheritance in the law, in fee simple, and that the
same are free and clear from all incumbrances whatever. Except recorded easements, building restrictions
if any and municipal and zoning ordinances.

and that the above bargained premises in the quiet and peaceable possession of the said party _____ of the second part, his heirs and assigns,
against all and every person or persons lawfully claiming the whole or any part thereof, it will forever WARRANT AND DEFEND.

In Witness Whereof, the said State Bank of Elkhorn
party of the first part, has caused these presents to be signed by Karl J. Kudick, its President, and
countersigned by Ruth E. Hill, its Secretary, at Elkhorn
Wisconsin, and its corporate seal to be hereunto affixed, this 18th day of July, A. D., 1978.

SIGNED AND SEALED IN PRESENCE OF

State Bank of Elkhorn

Corporate Name

Karl J. Kudick

President

COUNTERSIGNED:

Ruth E. Hill

Secretary

IMPORTANT NOTE: The surveyor has done no title research other than examination of the
legal description provided and copied on sheet 2. User of this plat should ascertain
that no other documents affect title to this property.

DATED : AUG 5, 1987

PROJ. NO. 2864
SHEET 2 OF 2 SHEETS