Plat of Survey

οf

Tax Parcel No: XUSW 0002


Beginning at the Northeast corner of Lot I of Block No. 1 of Rockwell Brothers Addition to the City of Elkhorn according to the recorded plat thereof, thence South 8 rods, thence East 5 rods thence North 8 rods; thence West 5 rods to the place of beginning.

Surveyed for: Ken Whitmore

105 West Rockwell

Elkhorn Wisconsin. 53121

Bearings referenced to C.S.M. 756.

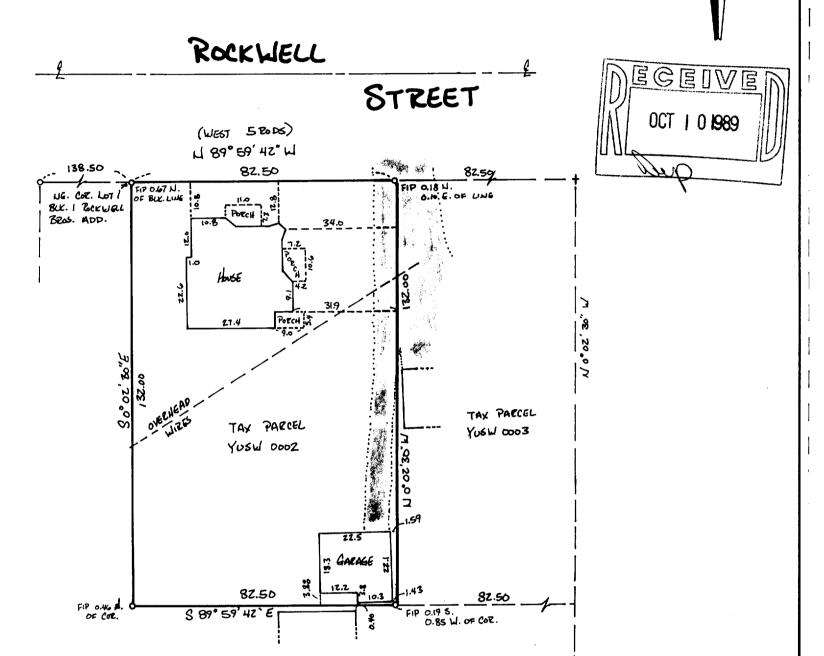

Copyright © 1989 by Jensen Surveying & Mapping S.C.
All rights reserved. No part of this survey plat may be reproduced or transmitted in any form by any means - graphic, electronic, or mechanical, including photocopying, tracing, or information storage and rerieval systems - without permission in writing from Thomas P.A. Jensen.

I. Thomas P.A. Jensen, Wisconsin Registered Land Surveyor, do hereby certify that this survey was performed by me, or under my direction, in full compliance with the owner's/agent's instructions and Chapter A-E 7 of the Wisconsin Administrative Code 'Minimum Standards For Property Surveys', and that this map is an accurate representation thereof to the best of my knowledge and belief.

Note: This survey plat is not certified unless signed and sealed in red ink.

Thomas P.A. Jensen R.L.S. 1084

