

- Concrete monu.
- Stone monu.
- (82.5') Platted Lot size
- 83.38' Measured Lot size
- Parking Light Poles

ONE STORY BRICK AND
CONCRETE BLOCK
BUILDING

SURVEYOR'S CERTIFICATE

I certify that I have surveyed the property described herein and that the plat shown hereon is an accurate survey and a true representation thereof and correctly shows the exterior boundary lines and location of buildings and other improvements on said property and the correct measurements thereof.

Lloyd L. Jensen
County Surveyor
Elkhorn, Wisconsin
Sept. 13, 1963

NOTE: ALL OVERTURE IN THE BLOCK
HAS BEEN DIVIDED AMONG THE LOTS
IN PROPORTION TO THE PLATTED
WIDTH, AS SHOWN ON CITY PLAT BOOK.

STREET NUMBER - 110 EAST WALWORTH STREET

SURVEY CERTIFICATE

July 31, 1963

Plat of survey of land described as follows: Lot seven (7) except the West forty-five (45) feet three and one-half (3-1/2) inches thereof and all of Lot eight (8) of Block 21; The East 119.1 feet of Lot 5 of Block 21; The East 1/2 of the South 36 feet of Lot 4 of Block 21, all of the original plat of the Village (now City) of Elkhorn, Wisconsin.

The undersigned hereby CERTIFIES to THE EQUITABLE LIFE ASSURANCE SOCIETY OF THE UNITED STATES, as of the above date, that the print of survey shown hereon correctly shows the location of all buildings, structures and other improvements situated on the above premises; and that, except as shown, there are no visible easements or rights of way across said premises or any other easements or rights of way of which the undersigned has been advised, no party walls, no encroachments on adjoining premises, streets or alleys by any of said buildings, structures or other improvements, and no encroachments on said premises by buildings, structures or other improvements situated on adjoining premises.

Lloyd L. Jensen
Lloyd L. Jensen, Surveyor
Reg. No. S-211

PLAT OF SURVEY OF

LAND LOCATED IN
THE CITY OF ELKHORN
WALWORTH COUNTY
WISCONSIN.

Lloyd L. Jensen
SURVEYOR

SCALE 1" = 40'

DATE SEPT. 13 1963




PLAT OF SURVEY

OF

PART OF LOTS 4-5-7-8, BLOCK 21
OF THE ORIGINAL PLAT TO THE CITY OF
ELKHORN, WALWORTH COUNTY, WISCONSIN.

E WASHINGTON STREET

E LINCOLN STREET

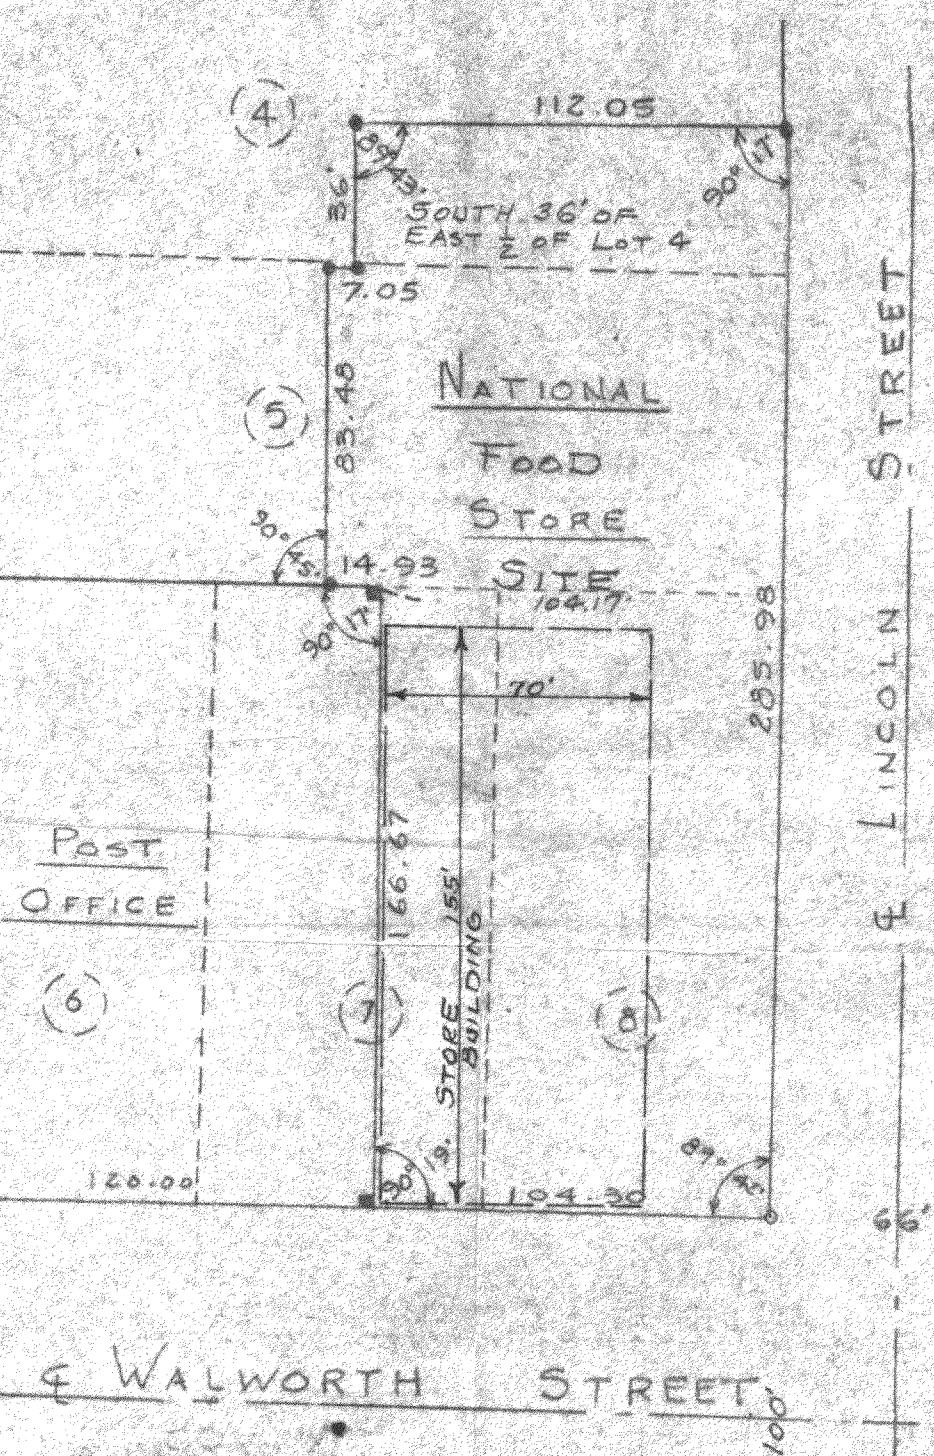

SURVEY AND PLAT BY
JENSEN & JOHNSON
CIVIL ENGINEERS AND SURVEYORS

Elkhorn, Wisconsin

LEGEND

- — Iron Pipe
- — Concrete Monument
- Scale 1" = 50'

WE CERTIFY: That we have surveyed the above described property and that the plat shown hereon is an accurate survey and a true representation thereof and correctly shows the exterior boundary lines and all divisions of said property.

Date MAY 16, 1963

Lloyd J. Jensen
LLOYD J. JENSEN, Partner

Wisconsin Registered Land Surveyor, No. S-211

OP-175