


Reduced

D. Cooper & CO., INC
Rt 4 Box 508B • Elkhorn WI 53121


Plat of Survey of Lot 13, Block 2 Hodges Addition to
the City of Elkhorn, Walworth County, Wisconsin.

RANDALL STREET

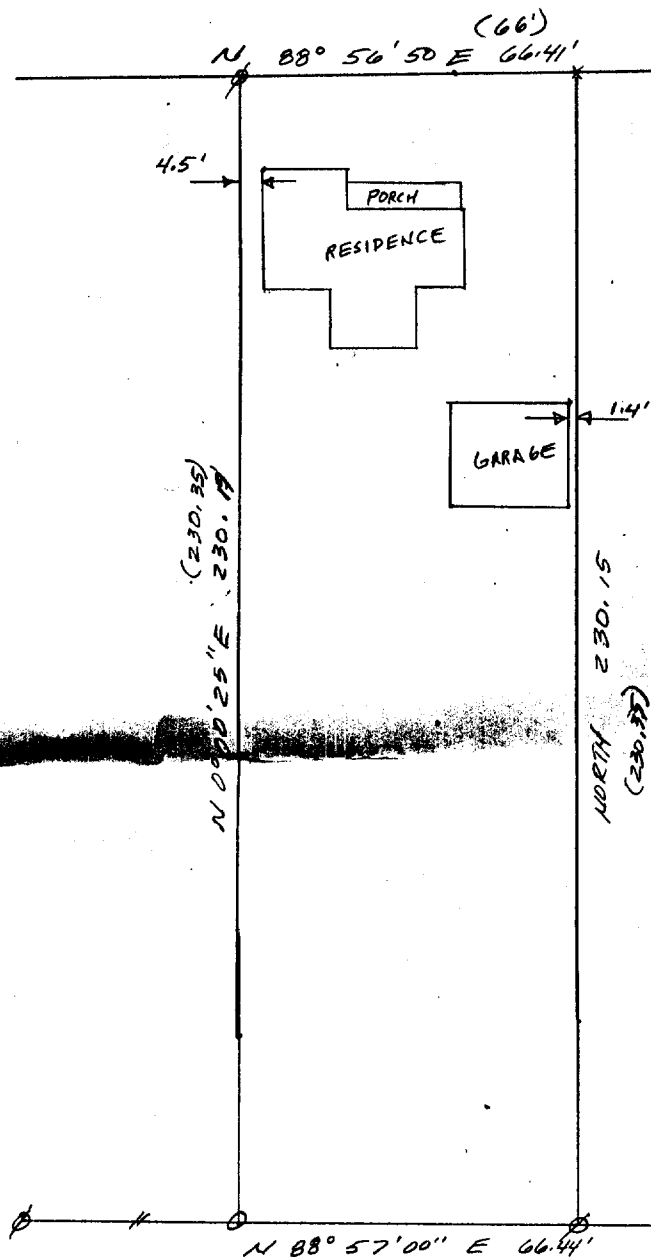

Legend

- ∅ found iron pipe
- + painted cross on asphalt drive
- set 1"x24" iron pipe

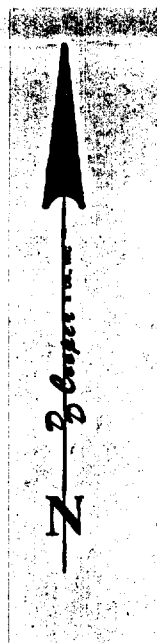



I hereby Certify that I have surveyed the parcel described hereon and that the above map is a true and accurate representation thereof to the best of my professional knowledge and belief.

Dated this 22 day of June, 1990

Daniel D. Cooper
Daniel D. Cooper

Bearing Reference: Easterly line of parcel assumed to Bear North-South

Survey ordered by Modern Realty - Elkhorn

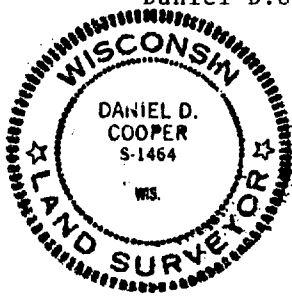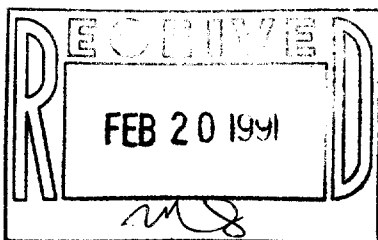

TAX KEY #
YHO 00023

4-610