

D Cooper & CO., INC
Rt 4 Box 508B • Elkhorn WI 53121



PLAT OF SURVEY OF

LOT 10, BLOCK 30, ROCKWELL'S ADDITION
TO THE CITY OF ELKHORN, WALWORTH
COUNTY, WISCONSIN.

ORDERED BY: Kurt Picknell
Elkhorn, WI

LEGEND

- Ø- Iron Pipe Found
- O- 1-1/4"x24" Iron Pipe Set
- ()- Record Dimension

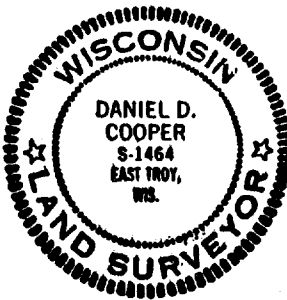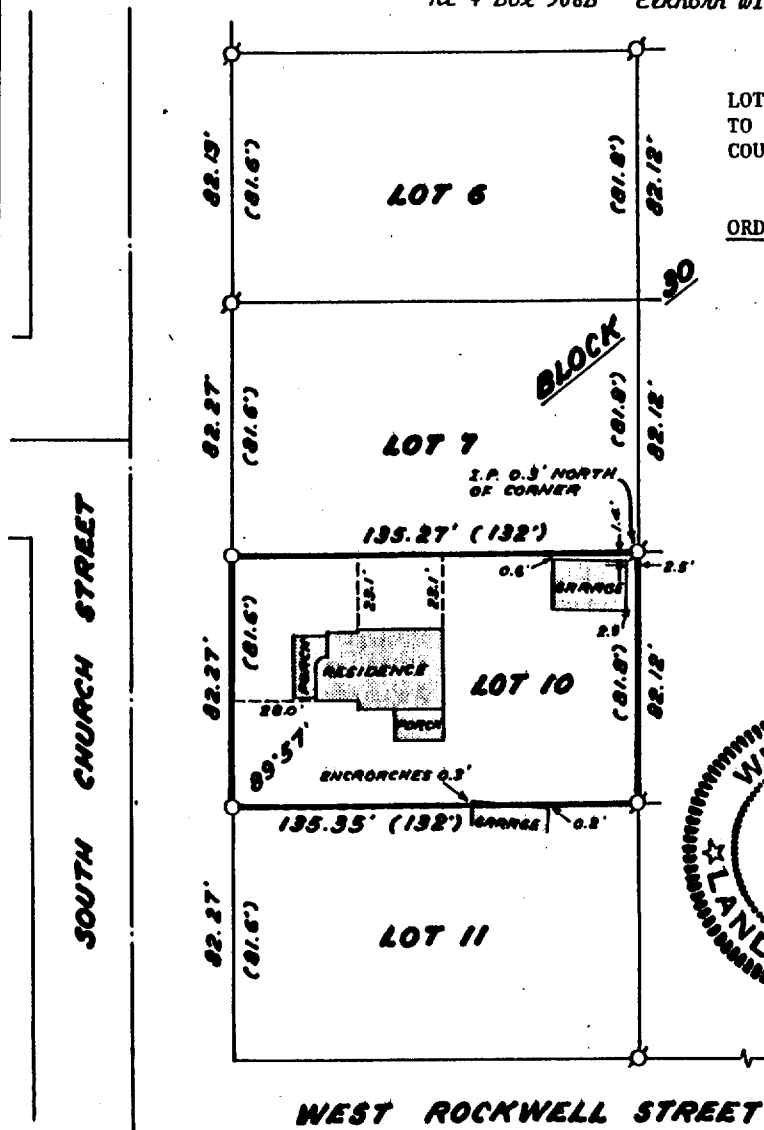


I HEREBY CERTIFY that I have surveyed the parcel described hereon and that this Plat of Survey is a true and accurate representation of the lot lines, and buildings thereon, to the best of my professional knowledge and belief.

Daniel D Cooper
Daniel D. Cooper, Registered Land Surveyor S-1464

0 10 20 30 40 50
SCALE IN FEET
1"=50'

Dated this 20th day of June, 1990 PROJECT NO. 3654

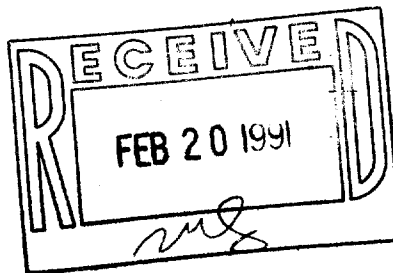

Reduced

TAX KEY #
YRW 00046

4-611