

WALWORTH COUNTY  
SURVEYING & MAPPING  
LAKE GENEVA, WISCONSIN

ROBINCREST

LANE

(S89°31'E 105.00')  
104.94'

89°57'20"

90°03'10"

LOT 53

(N0°29'E 20.63')  
210.64'

210.64'  
(N0°29'E 20.75')

PLAT OF SURVEY OF

LOT 53 OF GREEN ACRES SUBDIVISION,  
LOCATED IN SECTION 8, T 2 N, R 17 E,  
CITY OF ELKHORN, WALWORTH COUNTY,  
WISCONSIN.

ORDERED BY: REALTY WORLD-TAGGART  
756 MAIN STREET  
LAKE GENEVA, WISCONSIN  
53147

90°02'40"


10' WIDE UTILITY EASEMENT

89°56'50"

OVERHEAD UTILITIES ALONG LINE


WIRE FENCE ON LINE

104.97'  
(S89°31'E 105.00')

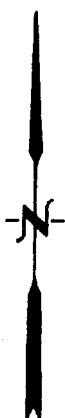

SCALE: 1"=30'

⊘ - IRON PIPE FOUND  
( ) - RECORDED AS

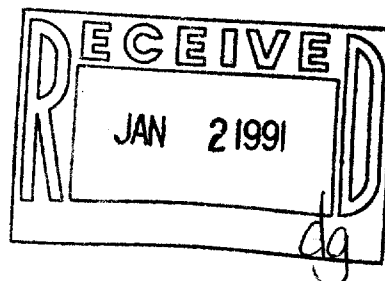

I HEREBY CERTIFY THAT I HAVE SURVEYED THE ABOVE DESCRIBED PROPERTY AND THAT THE ABOVE  
MAP IS A TRUE REPRESENTATION THEREOF AND SHOWS THE SIZE AND LOCATION OF THE PROPERTY,  
ITS EXTERIOR BOUNDARIES, THE LOCATION OF ALL VISIBLE STRUCTURES AND DIMENSIONS OF ALL  
PRINCIPAL BUILDINGS THEREON, BOUNDARY FENCES, APPARENT EASEMENTS AND ROADWAYS AND  
VISIBLE ENCROACHMENTS, IF ANY.

THIS SURVEY IS MADE FOR THE EXCLUSIVE USE OF THE PRESENT OWNERS OF THE PROPERTY, AND  
ALSO THOSE WHO PURCHASE, MORTGAGE, OR GUARANTEE THE TITLE THERETO WITHIN ONE (1) YEAR  
FROM DATE HEREOF.

*Robert M. Baerenwald*  
ROBERT M. BAERENWALD  
WISCONSIN REGISTERED LAND SURVEYOR, S-1508

DATE Aug. 31, 1989 JOB NO. 2051

NOTE: THIS IS NOT A CERTIFIED COPY UNLESS SEALED.

004-635

YGR00053