



WALWORTH COUNTY
SURVEYING & MAPPING
LAKE GENEVA, WISCONSIN
414-248-0505

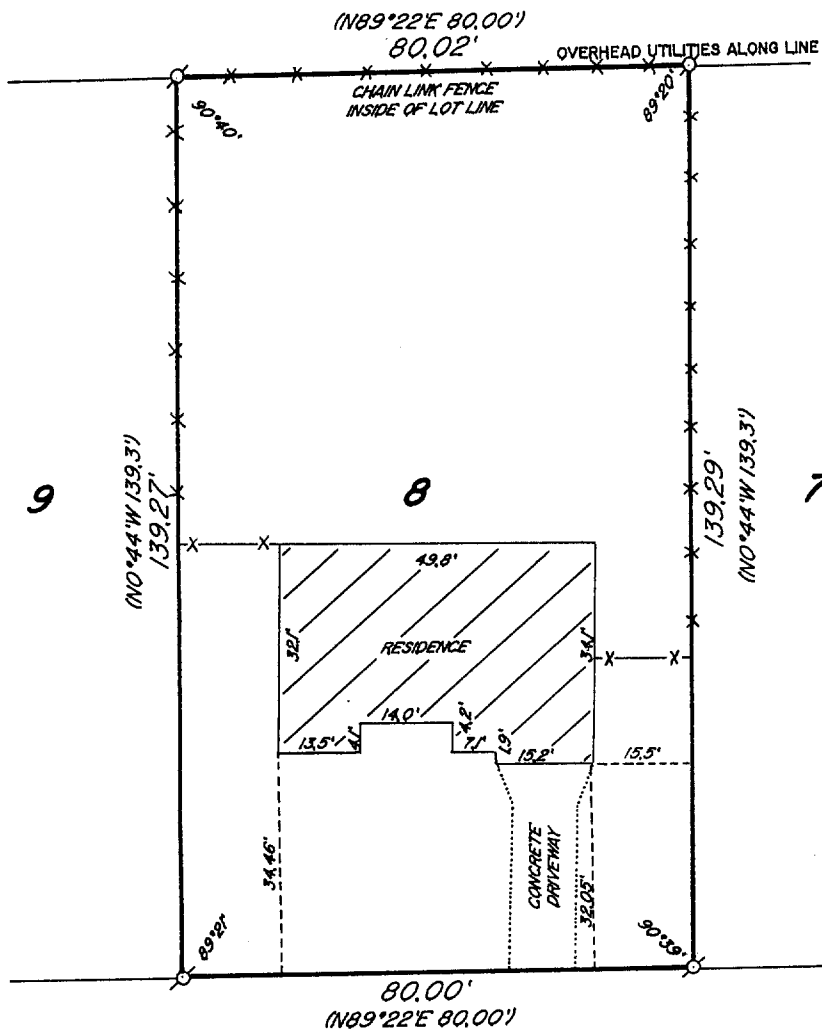


PLAT OF SURVEY OF
LOT 8 IN JAMES JONES ADDITION
TO THE CITY OF ELKHORN,
ACCORDING TO THE RECORDED
PLAT THEREOF, WALWORTH COUNTY,
WISCONSIN.

WEST ROCKWELL STREET

ORDERED BY: JEANETTE RAYMOND
67 JEWELL DRIVE
WILLIAMS BAY, WI 53191

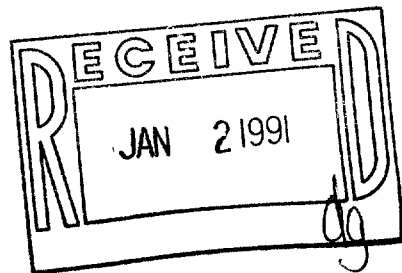

SCALE IN FEET

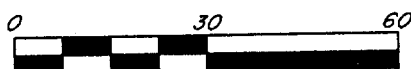

Ø - IRON PIPE FOUND
() - RECORDED AS

I HEREBY CERTIFY THAT I HAVE SURVEYED THE ABOVE DESCRIBED PROPERTY AND THAT THE ABOVE MAP IS A TRUE REPRESENTATION THEREOF AND SHOWS THE SIZE AND LOCATION OF THE PROPERTY, ITS EXTERIOR BOUNDARIES, THE LOCATION OF ALL VISIBLE STRUCTURES AND DIMENSIONS OF ALL PRINCIPAL BUILDINGS THEREON, BOUNDARY FENCES, APPARENT EASEMENTS AND ROADWAYS AND VISIBLE ENCROACHMENTS, IF ANY, TO THE BEST OF MY KNOWLEDGE AND BELIEF.

THIS SURVEY IS MADE FOR THE USE OF THE PRESENT OWNERS OF THE PROPERTY AND ALSO THOSE WHO PURCHASE, MORTGAGE OR GUARANTEE THE TITLE THERETO WITHIN ONE (1) YEAR FROM DATE HEREOF.

Robert M. Baerenwald
ROBERT M. BAERENWALD
WISCONSIN REGISTERED LAND SURVEYOR, S-1508

DATE: 11-28-1989
JOB NO. 2280

NOTE: THIS IS NOT A CERTIFIED COPY UNLESS SEALED

004-636

VJA 00008