ABERNATHY and ASSOCIATES Kenneth B. Abernathy Jr.

Wisconsin Registered Land Surveyor S-1594


Rt. 3, Box 273 Elkhorn, Wisconsin 53121 Phone: (414) 723-4260 (office) (414) 723-4813 (residence)

PLAT OF SURVEY

THE WEST 1/2 OF LOT 28 OF HARMONY ACRES SUBDIVISION FIRST ADDITION, LOCATED IN THE NORTHWEST 1/4 OF SECTION 6. TOWN 2 NORTH, RANGE 17 EAST, CITY OF ELKHORN, WALWORTH COUNTY, WISCONSIN.

ORDERED BY: CENTURY 21 WALTON REALTY 704 N. LINCOLN ELKHORN, WI. 53121


CURRENT OWNER: HUBERT ANDERSON W275 N1272 SPRINGHILL DRIVE PEWAUKEE, WI. 53072

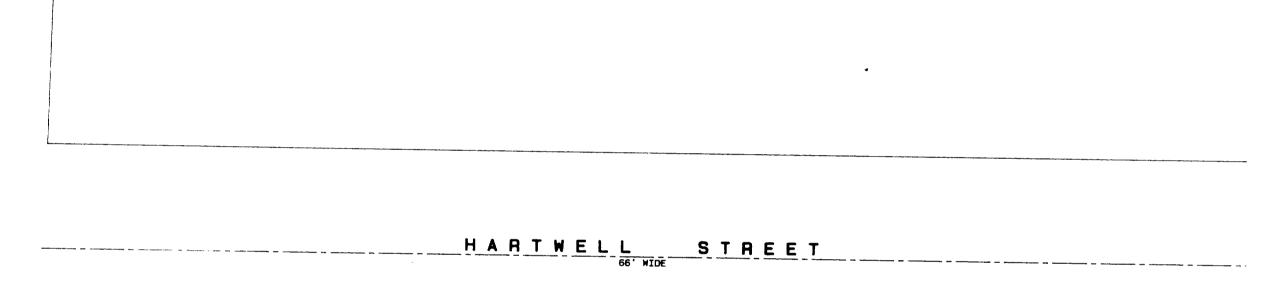

SCALE 1" = 30 FEET

KENNETH B. ABBRNATHY, JR. S-1594 BUSHORN,

NO SURVEYO

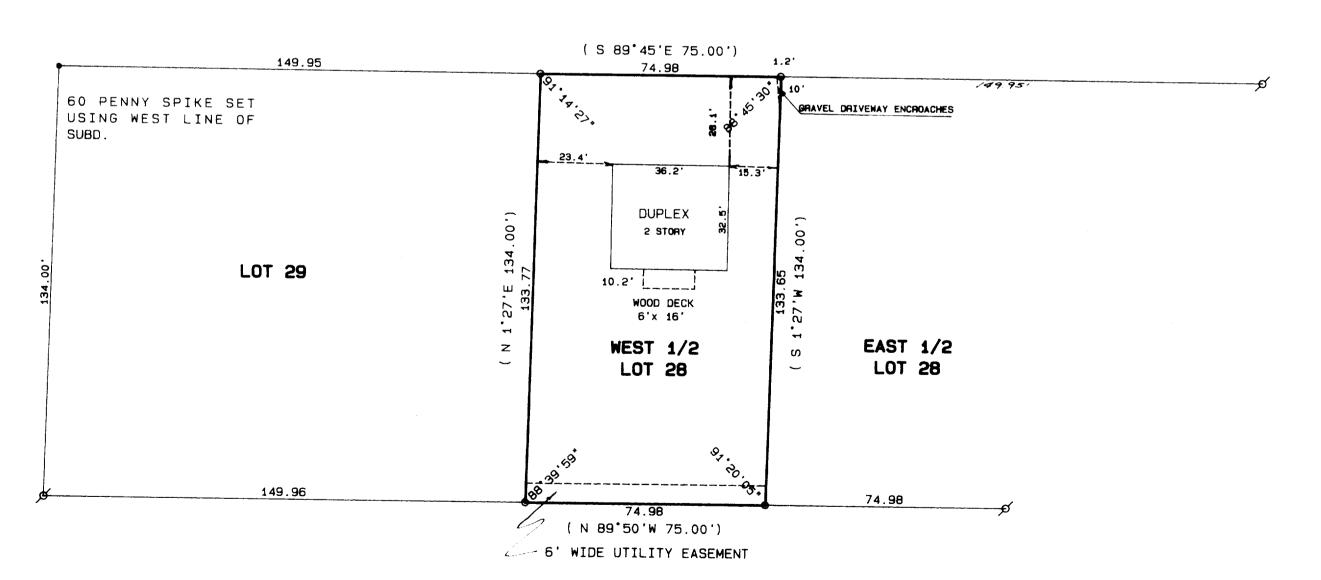

Legend

- FOUND IRON PIPE FOUND IRON ROD
- FOUND BRASS CAPPED MONUMENT * FOUND CONCRETE MONUMENT
- CHISEL CUT IN CONCRETE
- SET IRON ROD, 24" LONG, WEIGHING 1.5 LBS./LINEAL FT., 3/4" DIA.
- SET IRON ROD, 30" LONG, WEIGHING
- 4.5 LBS./LINEAL FT., 1-11/16" DIA

(xx) RECORDED AS DIMENSION


-x-x- EXISTING FENCE

SCALE: 1"= 30 FEET

"I hereby certify that I have surveyed the above described property and that the above map is a true representation thereof and shows the size and location of the property, its exterior boundaries, the location of all visible structures and dimensions of all principal buildings thereon, boundary fences, apparent easements, roadways and visible encroach

ments, if any."
"This survey is made for the use of the present owners of the property, and also those who purchase, mortgage, or guarantee the title thereto within one year from date

KENNETH B. ABERNATHY, JR. WISCONSIN REGISTERED LAND SURVEYOR, V

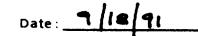

Job No. 71.912



