


GETZEN STREET

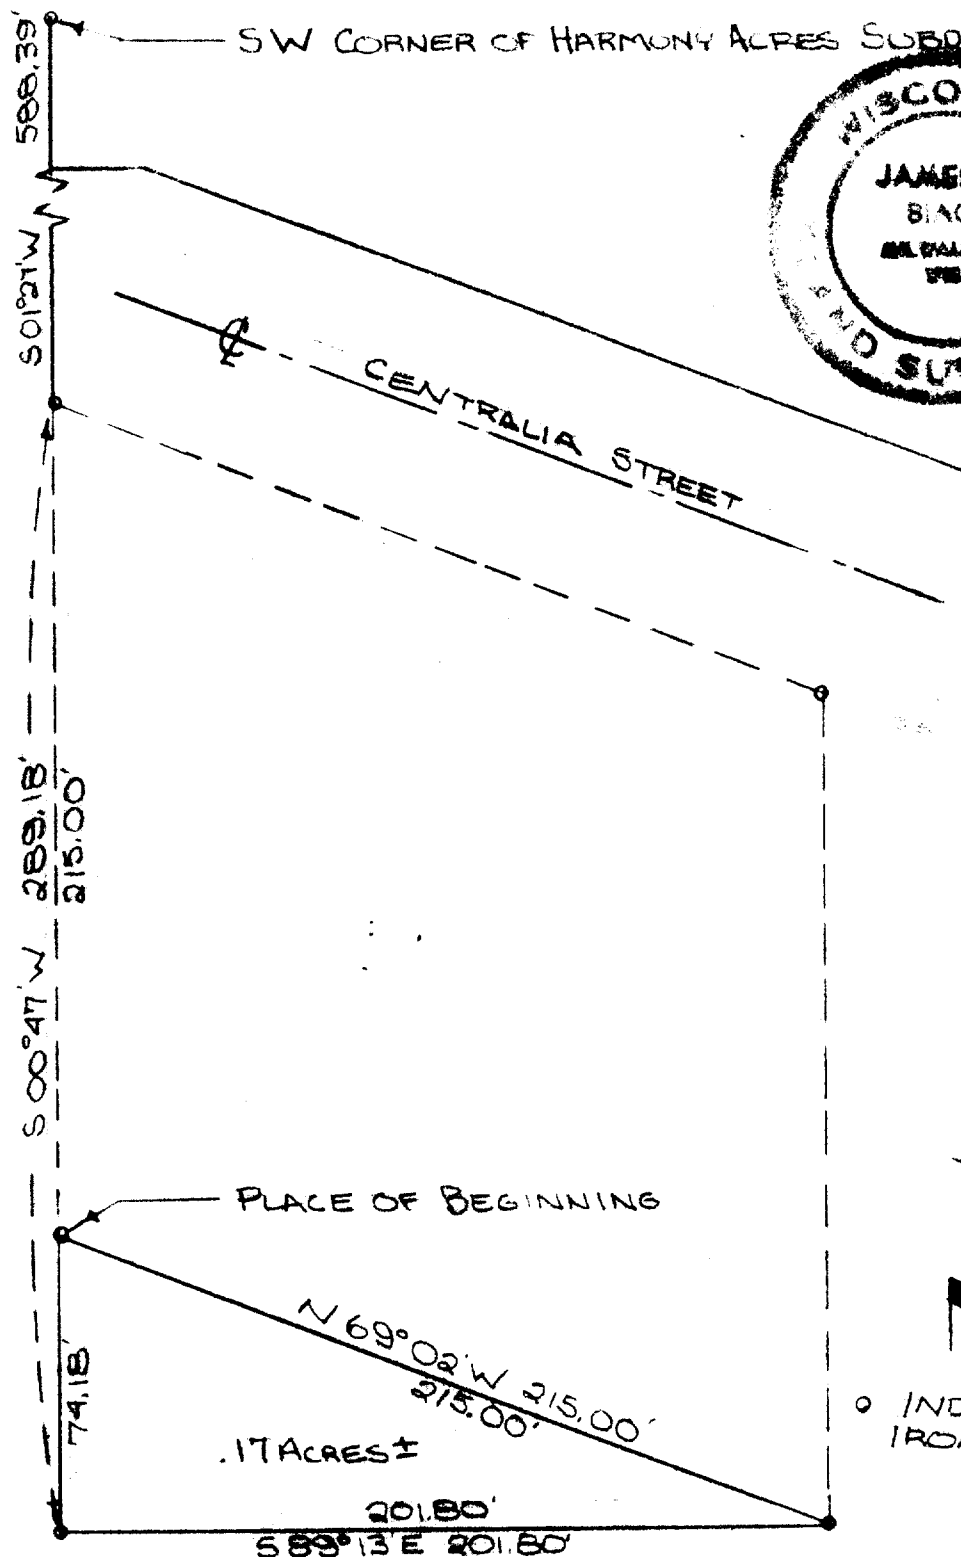

DESCRIPTION: Commencing at the SW corner of Harmony Acres Subdivision in the City of Elkhorn, Walworth County, Wisconsin; thence S. 01°27' W. along the East line of Getzen Street, 588.39 feet, thence S. 00°47' W. along the East line of said Street 215.00 feet to the place of beginning of the lands hereinafter described to-wit; thence continue S. 00°47' W. along the East line of said Street 74.18 feet, thence S. 89°13' E. 201.80 feet, thence N. 69°02' W. 215.00 feet to the place of beginning, containing .17 acres of land more or less.

CERTIFICATE: I, James F. Biagi, surveyor, do hereby certify that I have surveyed the property hereon described.

June 4, 1971

James F. Biagi RLS 272

V-SE-9A (part of)

4-6A