


VAN BUREN STREET

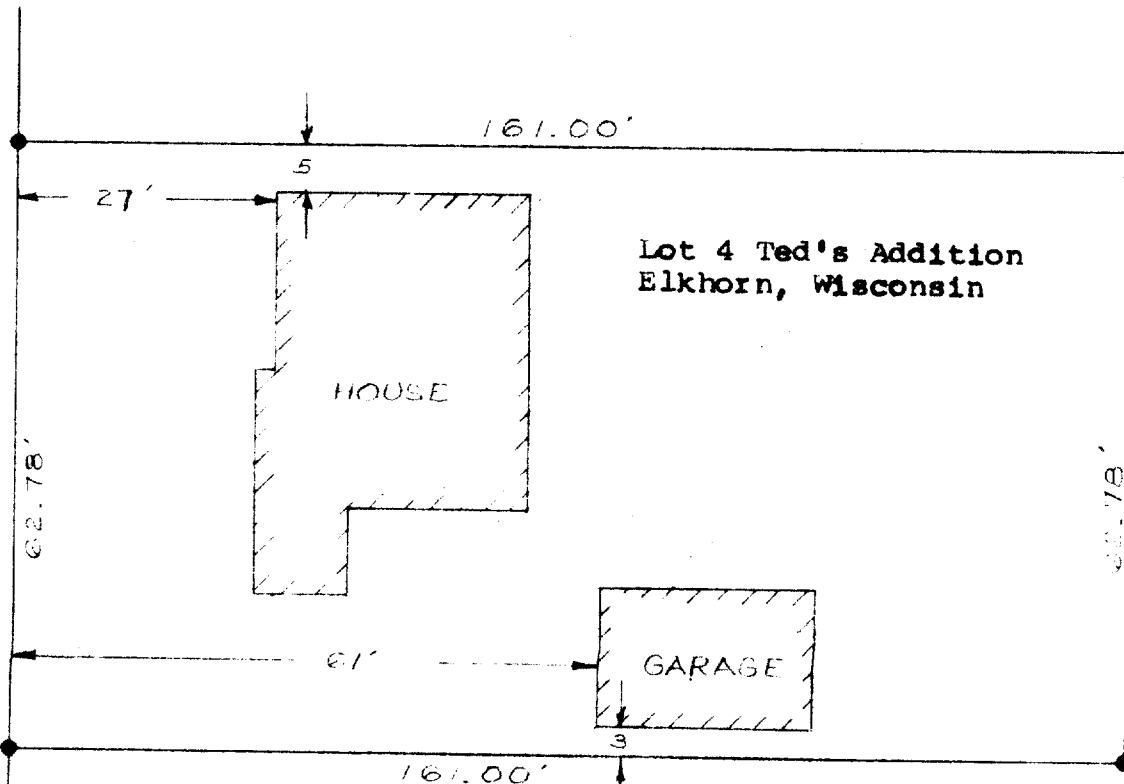

Lot 4 Ted's Addition  
Elkhorn, Wisconsin

HOUSE

GARAGE



- Iron Pipe Found
  - Iron Pipe Set
- Scale 1"=20'

42.0'

DESCRIPTION:

Lot 4, of Ted's Addition to the City of Elkhorn,  
Walworth County, Wisconsin.

CERTIFICATE:

I, James F. Biagi, surveyor, do hereby certify  
that I have surveyed the lands hereon described,  
and that all improvements are as hereon shown.

DATE:

May 26, 1971

*James F. Biagi*  
James F. Biagi R.L.S.272



YTA-4

4-70