


SECOND AVE.

NORTH WISCONSIN STREET.

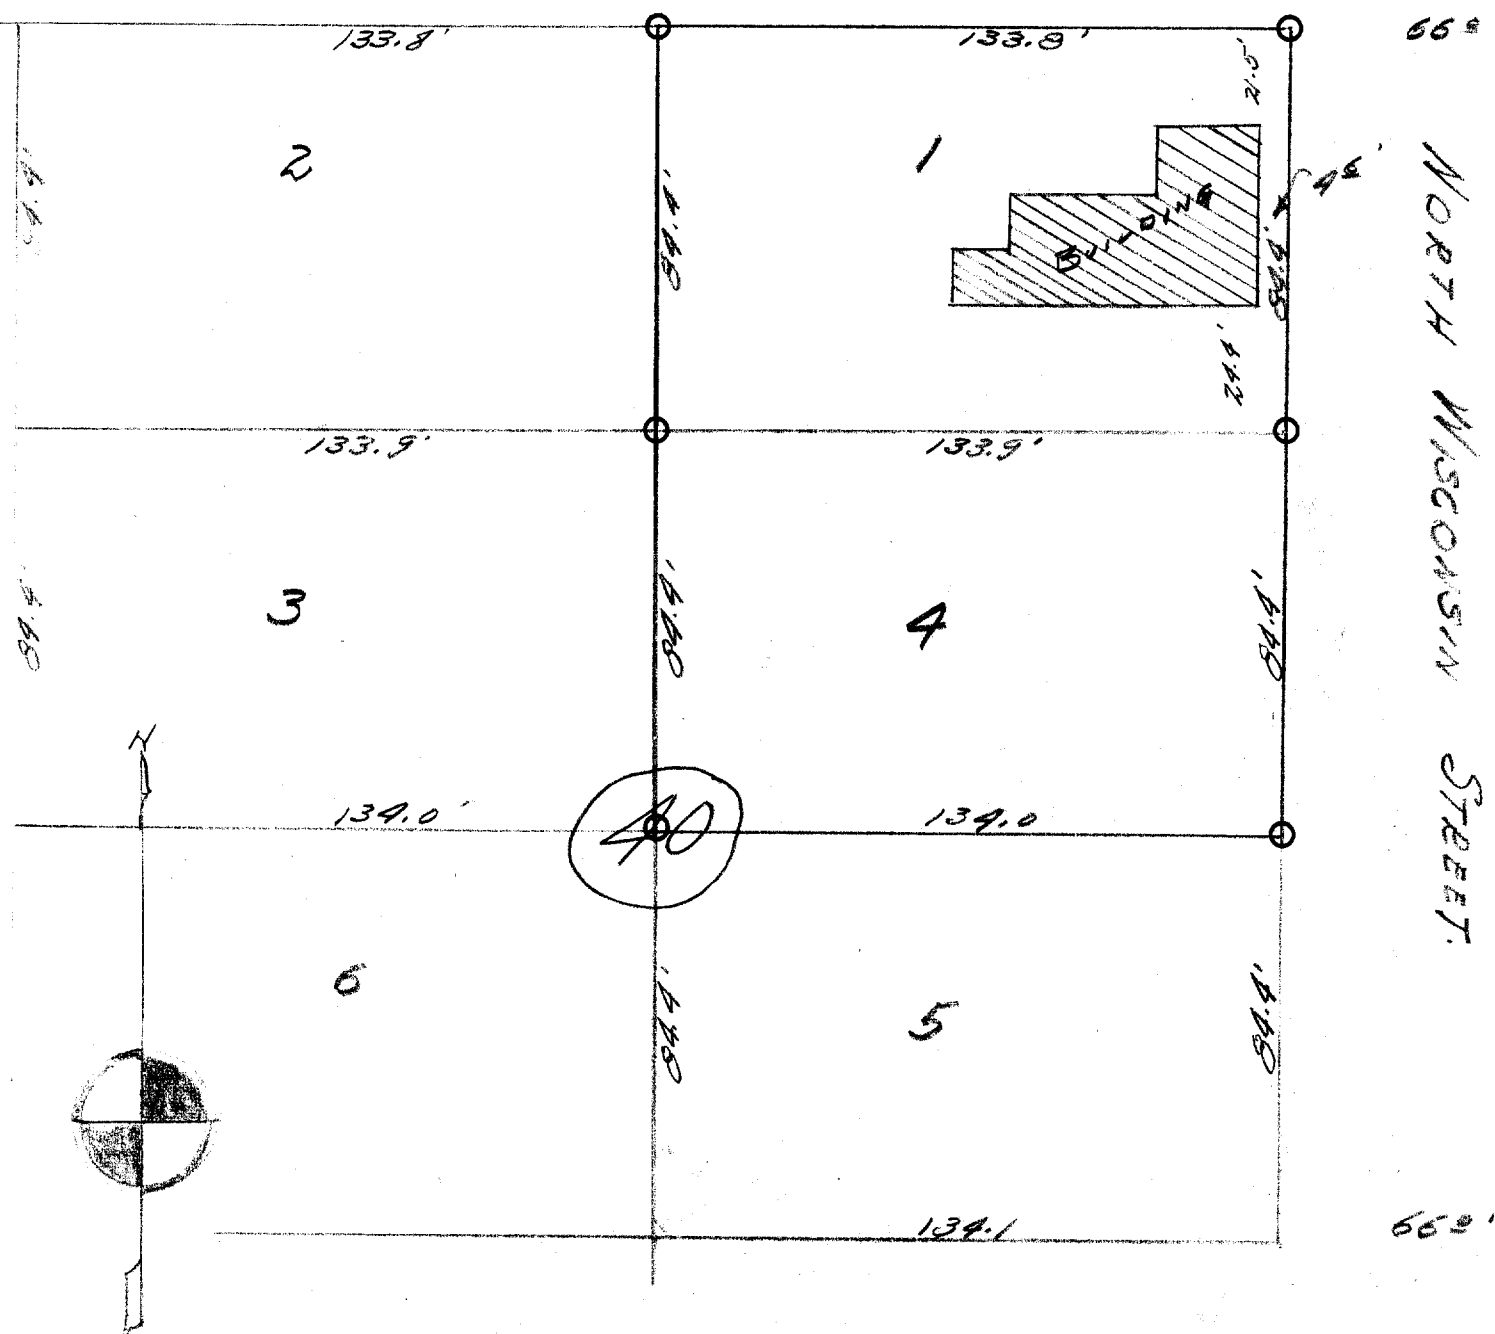

## DESCRIPTION:

Lot 1, and Lot 4, Block 40, Davis Addition to the City of Elkhorn,  
Walworth County, Wisconsin.

## CERTIFICATE:

I, Joseph M. Biagi, hereby certify that I, have on this the 7th day of June, 1954, surveyed the above described property according to the official record on file in the office of the Recorder of Deeds in and for Walworth County, Wisconsin, and find that the measurements and bearings of the boundary lines of said property are in substantial agreement with those on said official record and that no encroachments exist and that the relation of the building located on said property as of this date, to the boundary lines of said property, is as portrayed hereon.

SIGNED AND SEALED THIS 11TH DAY OF JUNE 1954.

Joseph M. Biagi. Professional Engineer.  
Elkhorn Wisconsin.