
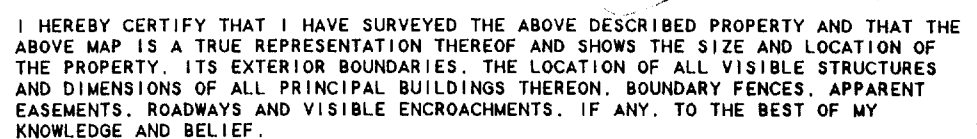


414-728-6737

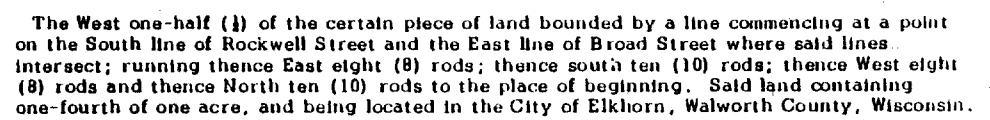

THIS SURVEY IS MADE FOR THE USE OF THE PRESENT OWNERS OF THE PROPERTY. AND ALSO THOSE WHO PURCHASE. MORTGAGE. OR GUARANTEE THE TITLE THERETO WITHIN ONE (1) YEAR FROM DATE HEREON.

ORDERED BY: RE/MAX-LAKES AREA REALTORS
1815 N. SHORE DRIVE
DELAVER, WI. 53115

DAVID F. ABELL
WISCONSIN REGISTERED LAND SURVEYOR. S-1596

August 26, 1992

DATE _____ JOB NUMBER - 92191
NOTE: THIS IS NOT A CERTIFIED COPY UNLESS SEALED.

YUSW-4

004-764