


669'

52-7

NORTH WISCONSIN ST.

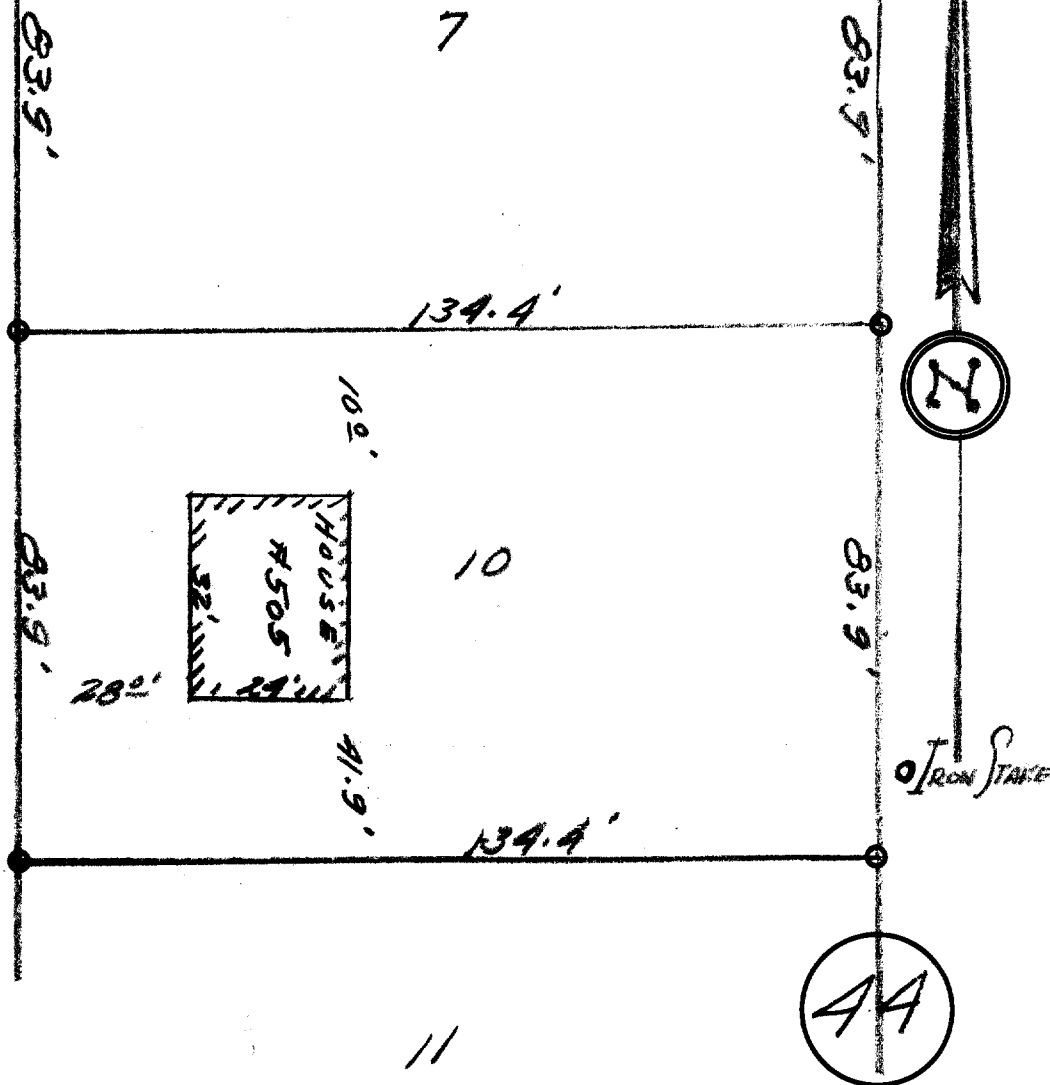

DESCRIPTION:

Lot 10 Block 44 Davis Addition to the City of Elkhorn, Walworth County, Wisconsin.

CERTIFICATE:

STATE OF WISCONSIN) ss.
WALWORTH COUNTY.)

I, Joseph M. Biagi, do hereby certify that I have made the above survey, according to official records; that the survey of the lot and information relative to the building located on said lot, all as shown on the above survey, is true and correct as indicated and marked on the above map.

Signed and sealed this 16th day of April 1952.

Joseph M. Biagi
Joseph M. Biagi, Professional Engineer
Elkhorn Wisconsin.